


T. 1 N., R. 2 W., W. M.

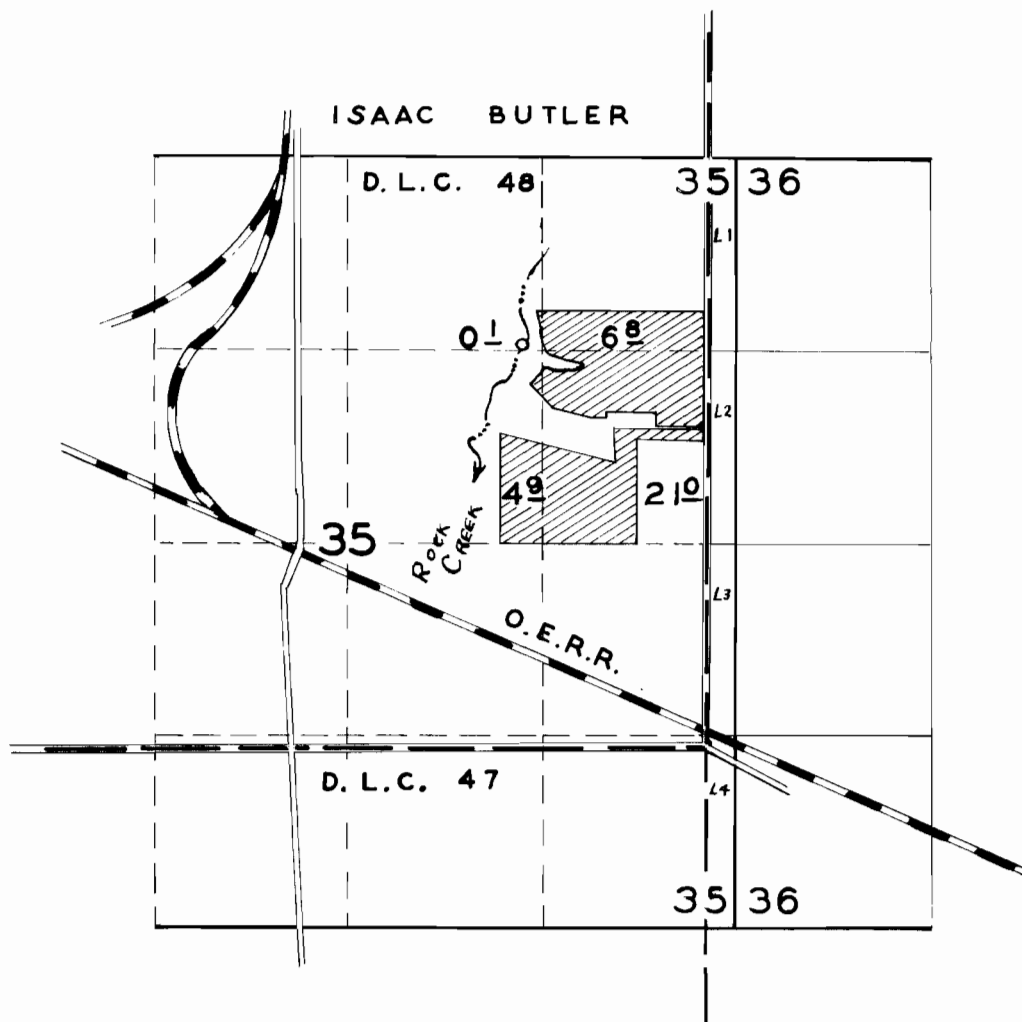

FINAL PROOF SURVEY

UNDER

Application No. 26446 Permit No. 20737

IN NAME OF

ALBERT E. KEHRLI

Surveyed 4 - 10 1956 by M. BISH