


T.35, R. 2 & 3 W.W.M.

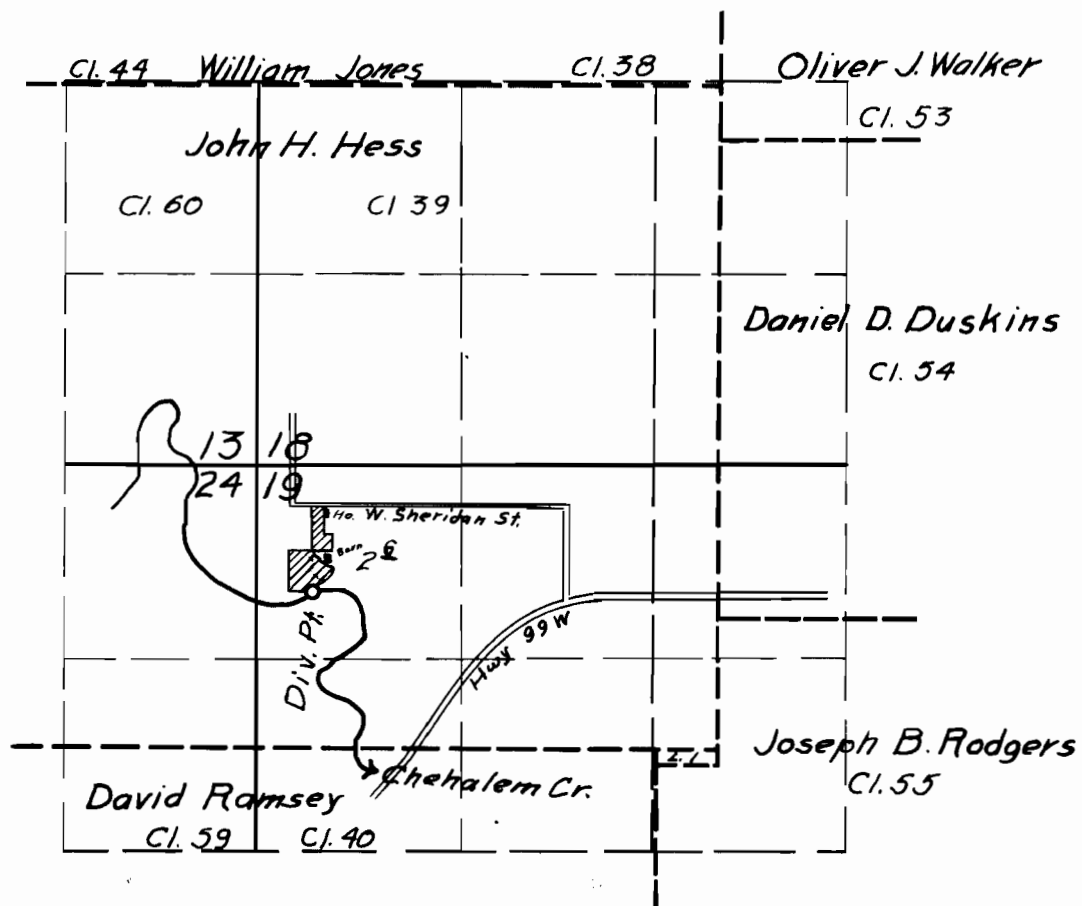

FINAL PROOF SURVEY

UNDER

Application No. 26464. Permit No. 20746

IN NAME OF

HAROLD W. NOYES

Surveyed 30 Sept. 1955, by *Robert H. [Signature]*