


T. 2 S., R. 2 W., W.M.

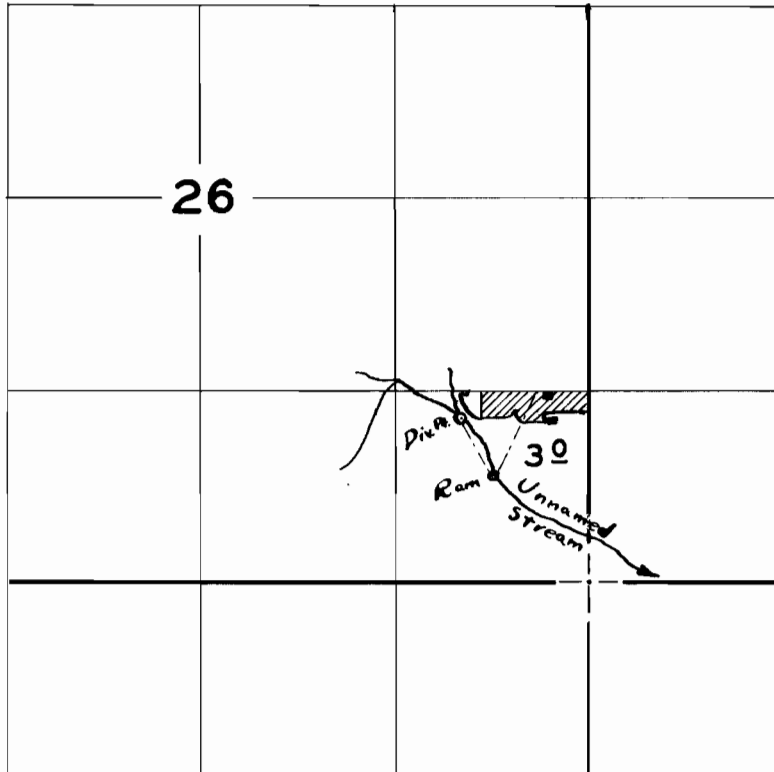

**FINAL PROOF SURVEY**

UNDER

Application No. 26490 Permit No. 20761

IN NAME OF

G. H. MILLER

Surveyed 4 - 30 1956, by M. BISH