


T. 7N R. 2W W. M.

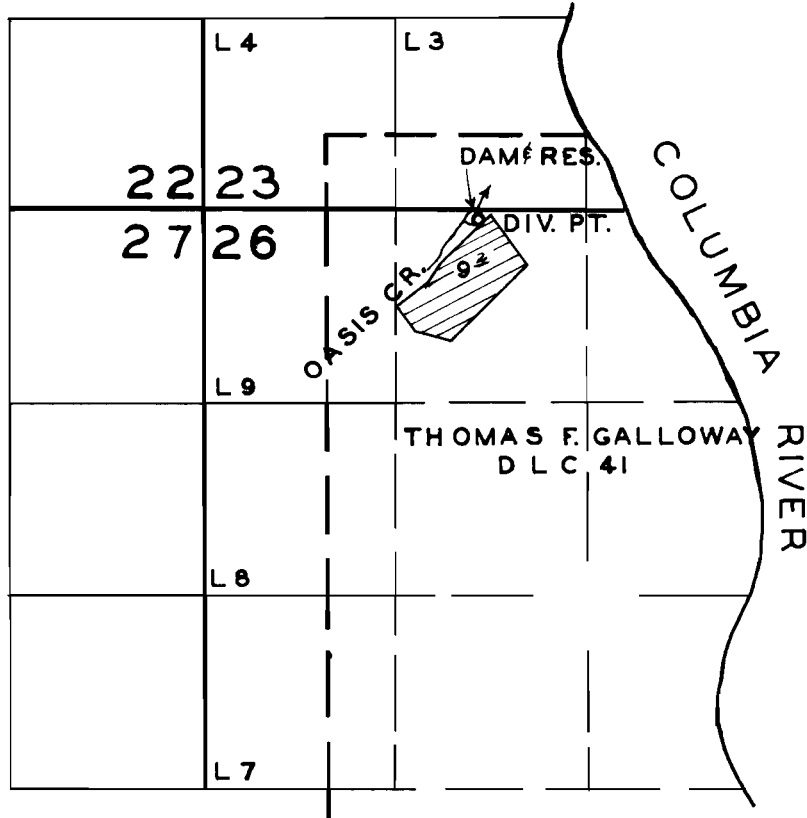

**FINAL PROOF SURVEY**

UNDER

Application No. 265.08... Permit No. 20778....

IN NAME OF

**C. M. KELLY**

Surveyed AUG. 22, 1956, by R. H. WHITBY....

1956 V  
R. H. W.