


T. 4 N. R. 3 W. W.M.

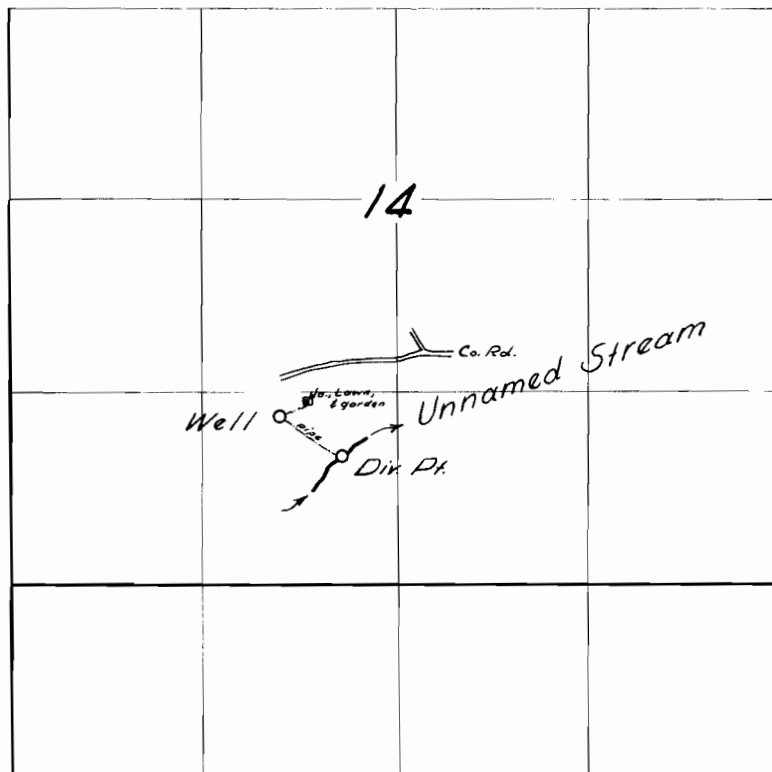

FINAL PROOF SURVEY
UNDER

Application No. 26533 Permit No. 20794
IN NAME OF

G. H. EARL

Surveyed 15 July 1956, by A. Whitney