


T. 2S. R. 2E. W.M.

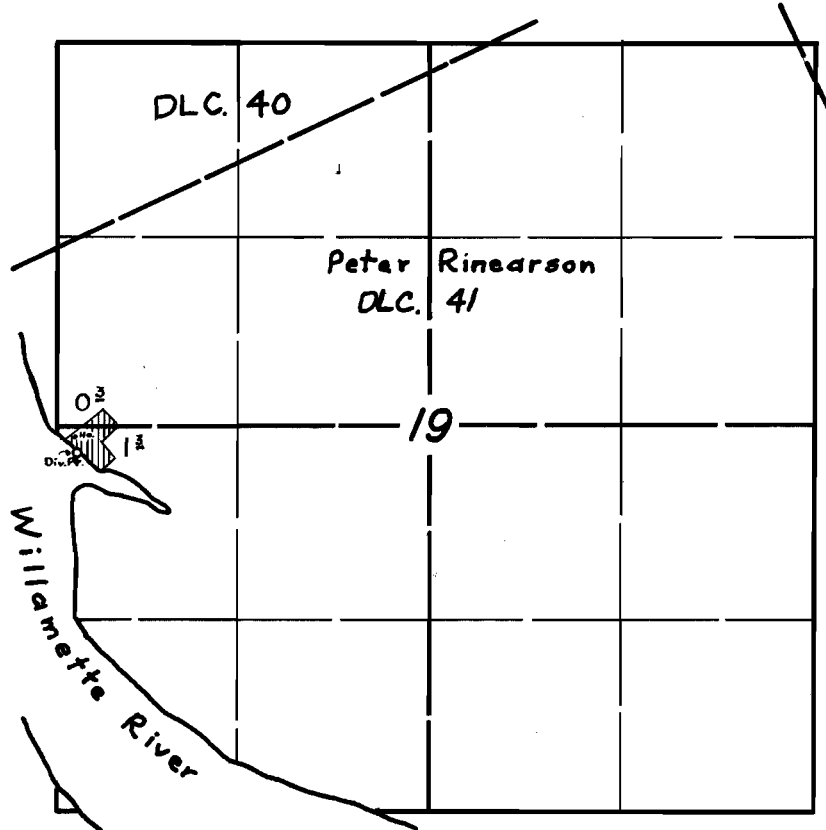

FINAL PROOF SURVEY
UNDER

Application No. 26547 Permit No. 20804
IN NAME OF

MRS. J. F. MANEWAL

Surveyed 15 May 1956 by M. Bish

MB