
## T. 1 S., R. IW., W.M.

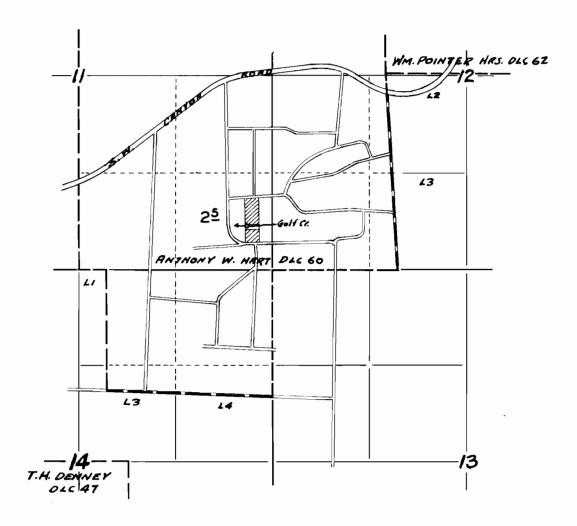

## FINAL PROOF SURVEY

**UNDER** 

Application No. 26798 Permit No. 20942
IN NAME OF

LYLE H. COBB

Surveyed 4 - 17 1956 by M. BISH