


T.1N. R.3W. W.M.

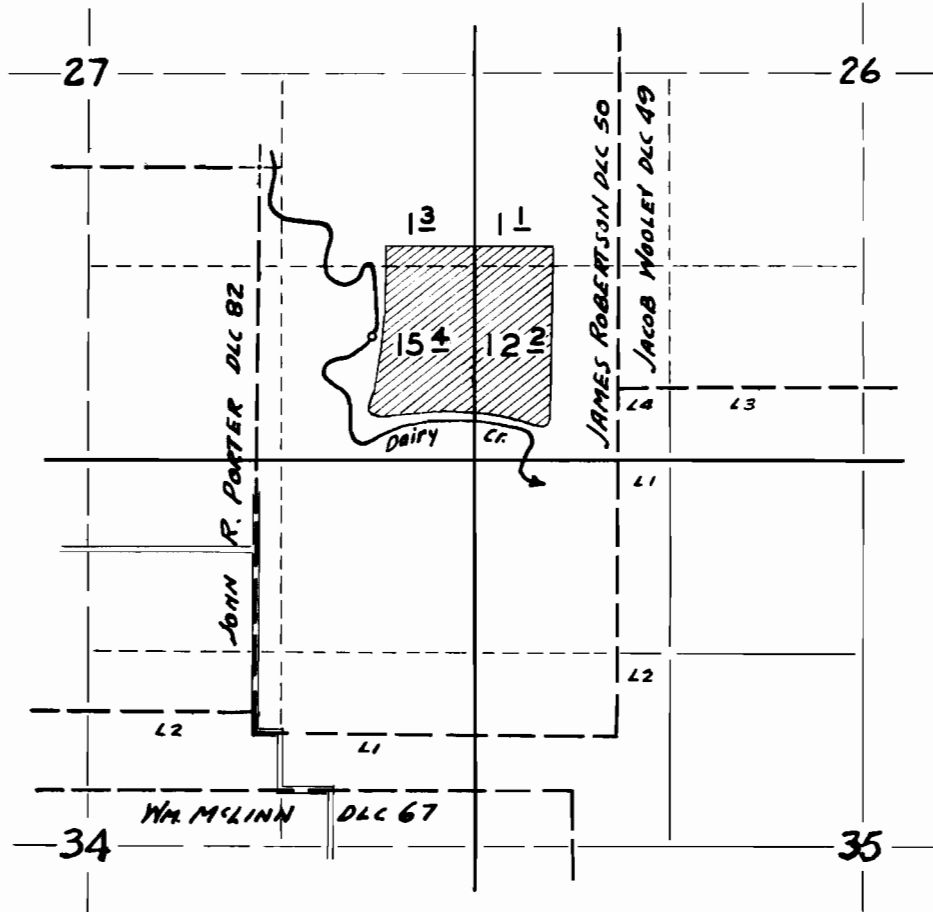

FINAL PROOF SURVEY

UNDER

Application No. 26801 Permit No. 20943

IN NAME OF

BERNARD SEUS

Surveyed 4 - 24 1956 by R.H. WHITBY