


T. 1N., R. 3W., W.M.

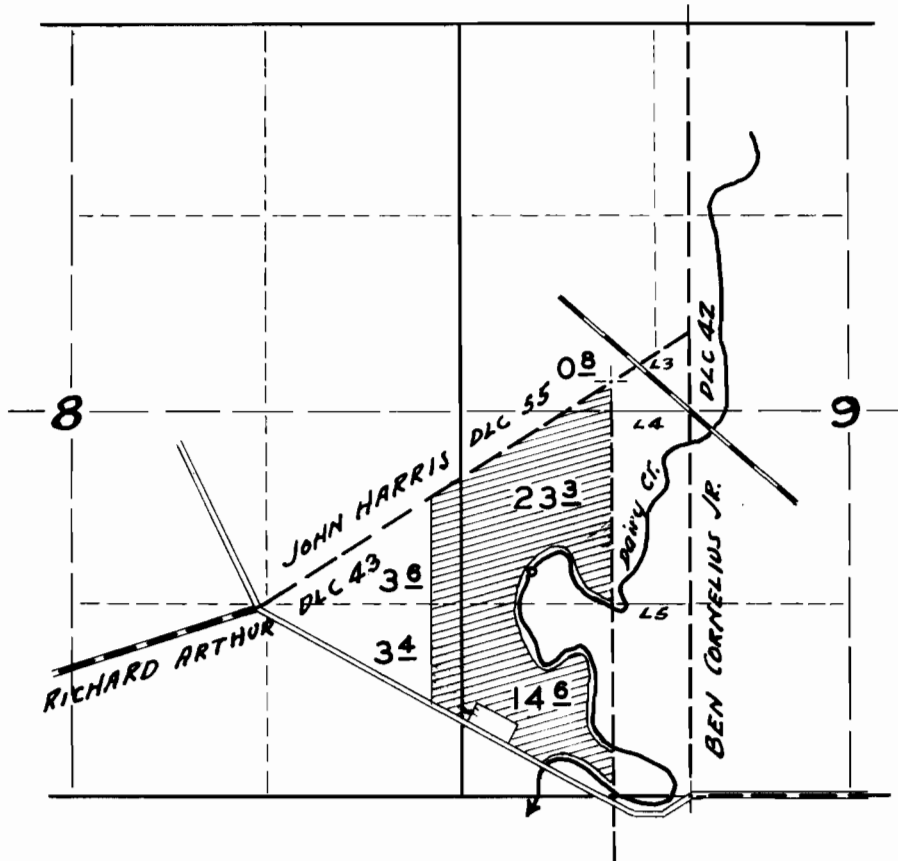

FINAL PROOF SURVEY

UNDER

Application No. 26810 Permit No. 20944

IN NAME OF

.....ADELBERT KEMPER.....

Surveyed 4 - 17 1956 by R. H. WHITBY.