


T. 5S. R. 1W. W.M.

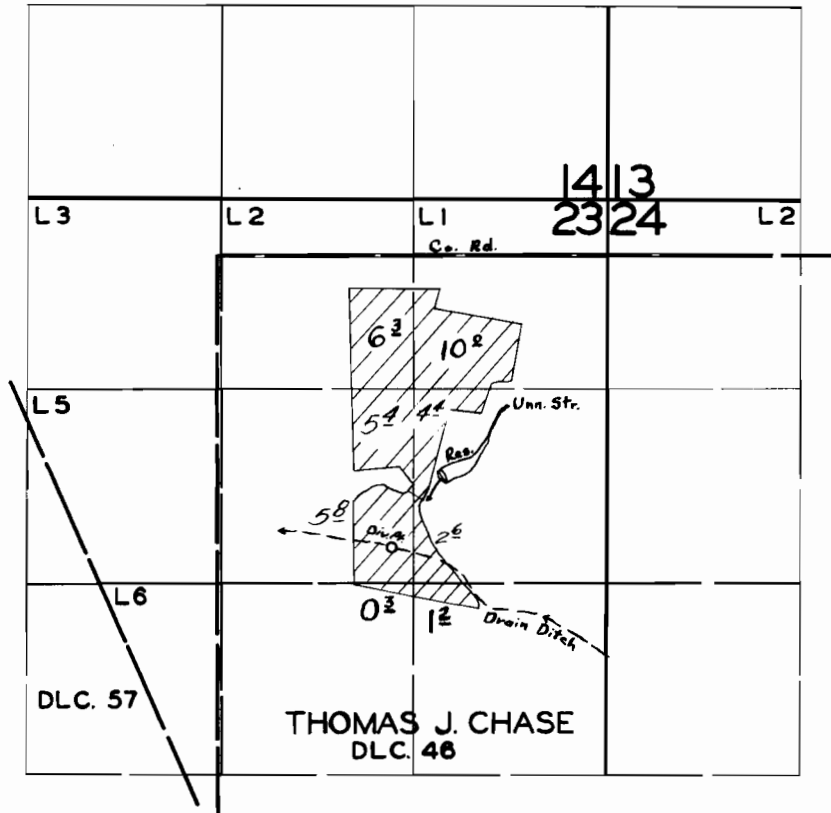

FINAL PROOF SURVEY
UNDER

Application No. 24614 Permit No. 20957.
IN NAME OF

ANTON H. & RUBY M. DOUTHIT

Surveyed 20 MAR. 1956, by R.D. BEST

DFK-2D-77

RWB