


T. 2 N., R. 2 & 3 W., W.M.

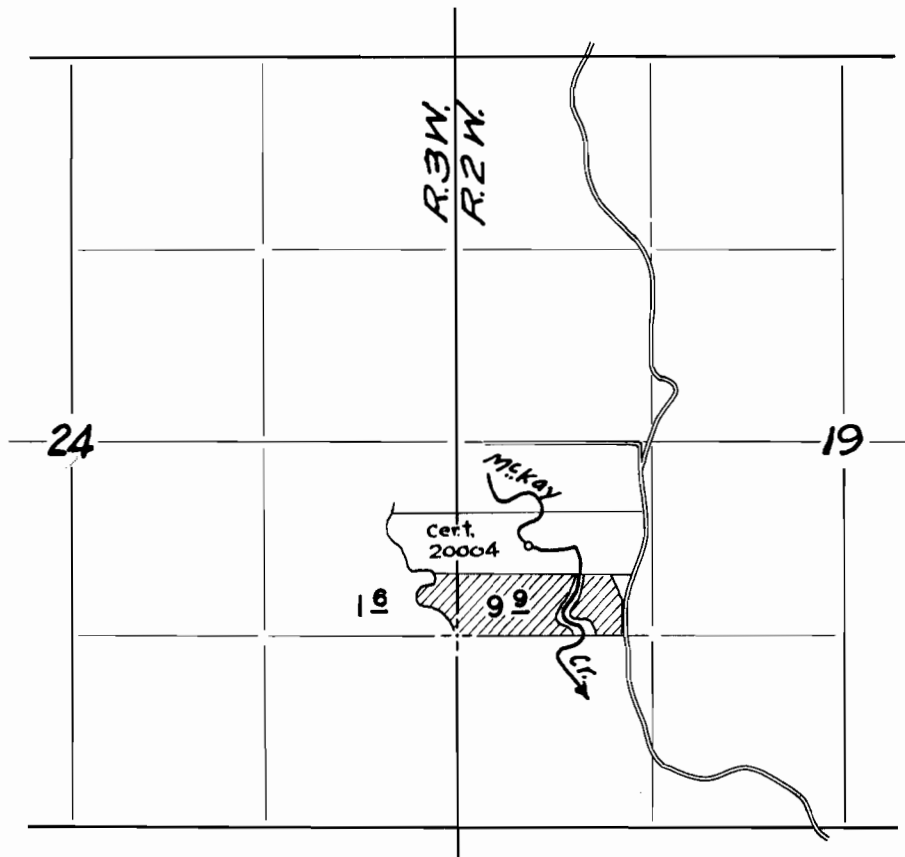

FINAL PROOF SURVEY

UNDER

Application No. 25638 Permit No. 20973

IN NAME OF

EUPHEMIA ANN MEYER

Surveyed 4-12 1956, by M. BISH