


T. 2 S., R. 2 W., W. M.

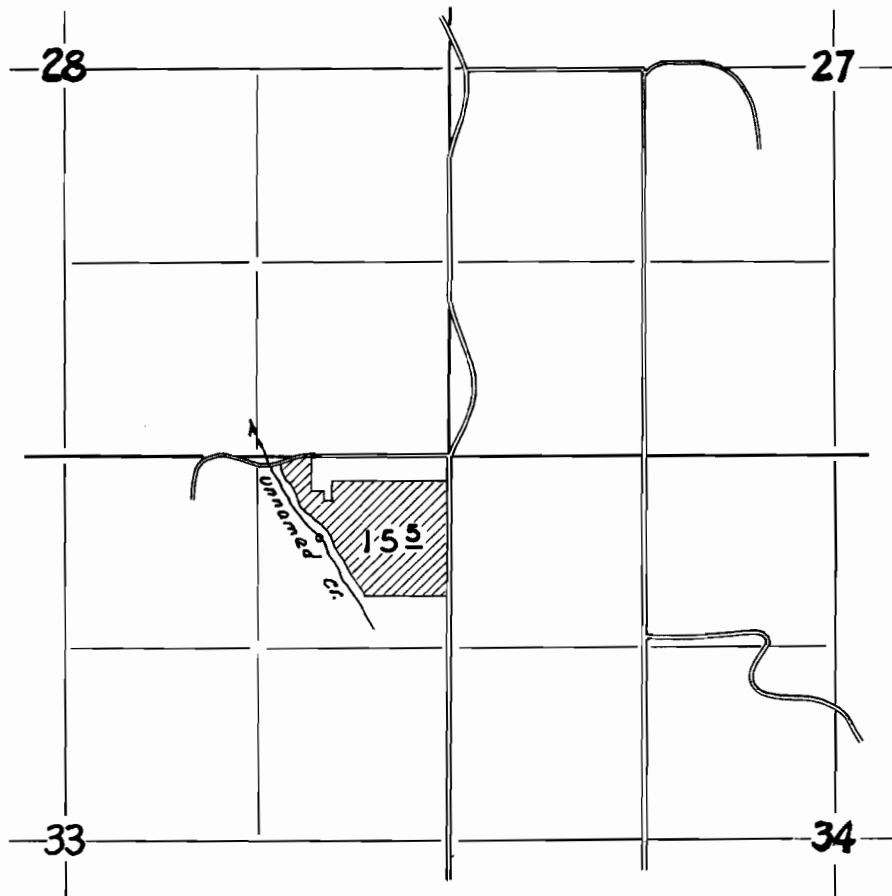

FINAL PROOF SURVEY

UNDER

Application No. 25832 Permit No. 20979

IN NAME OF

BENNETT B. BOOTH

Surveyed 5 - 9 1956, by M. BISH