


T. 2 N., R. 4 W., W.M.

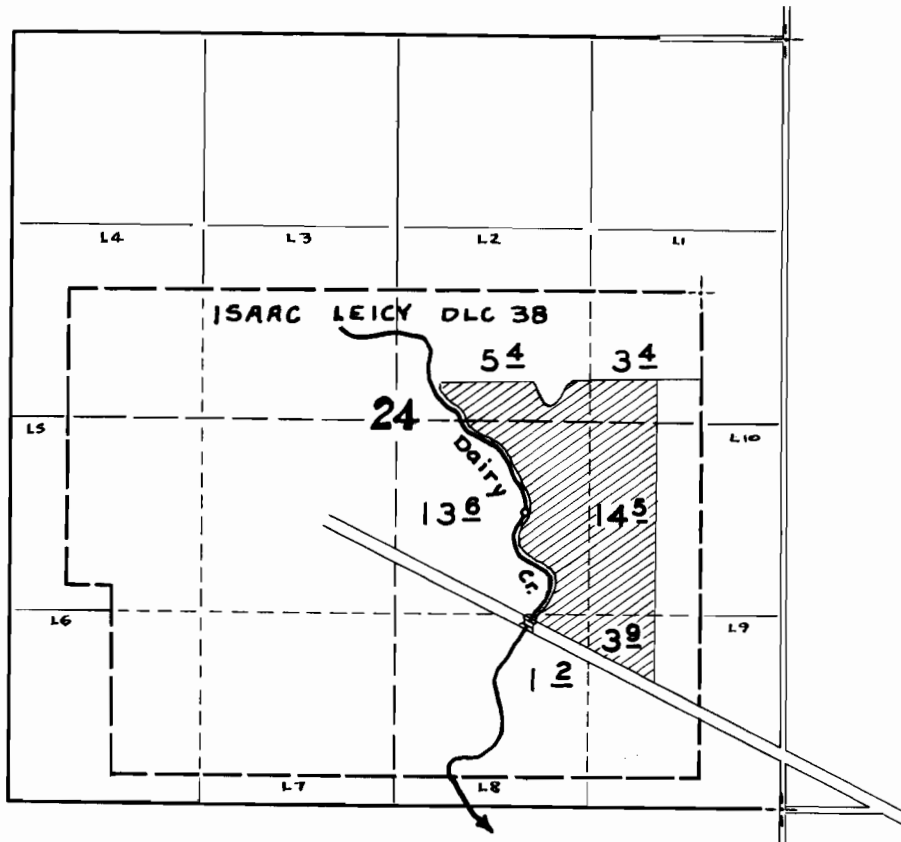

**FINAL PROOF SURVEY**  
UNDER

Application No. 25836 Permit No. 20980  
IN NAME OF

A. J. RANZAU

Surveyed 4 - 12 1956, by R. H. WHITBY