


T.2 S., R.2 W., W.M.

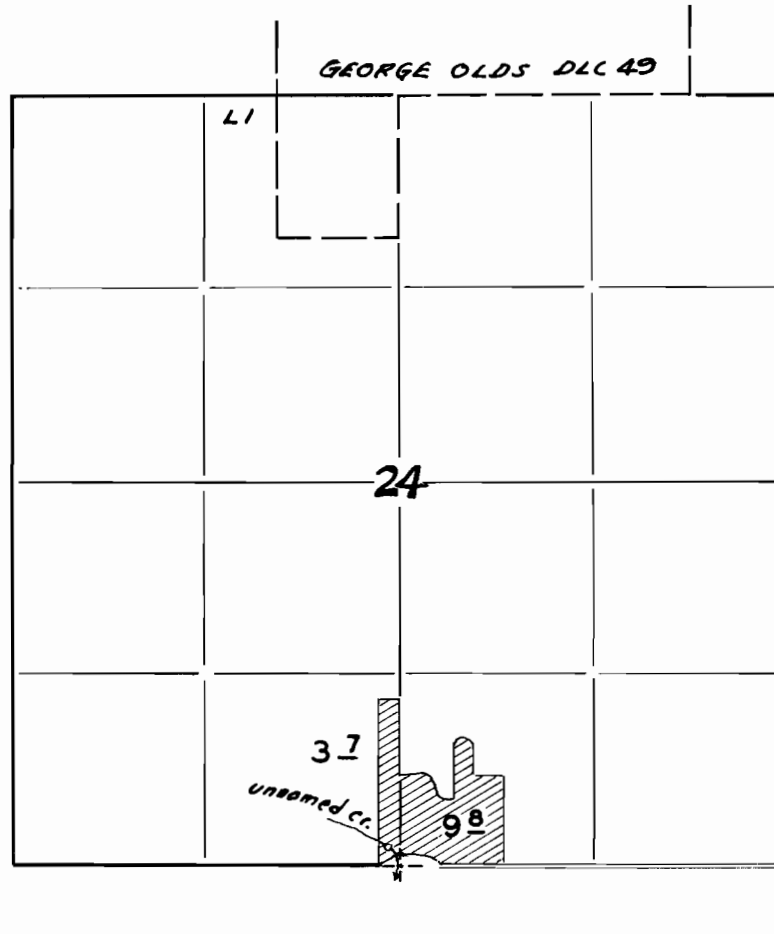

FINAL PROOF SURVEY

UNDER

Application No. 26622 Permit No. 21013

IN NAME OF

HARLON A. SCHLICHTING

Surveyed 5 - 8 1956, by M. BISH