


T. 9S. R. 5W. W.M.

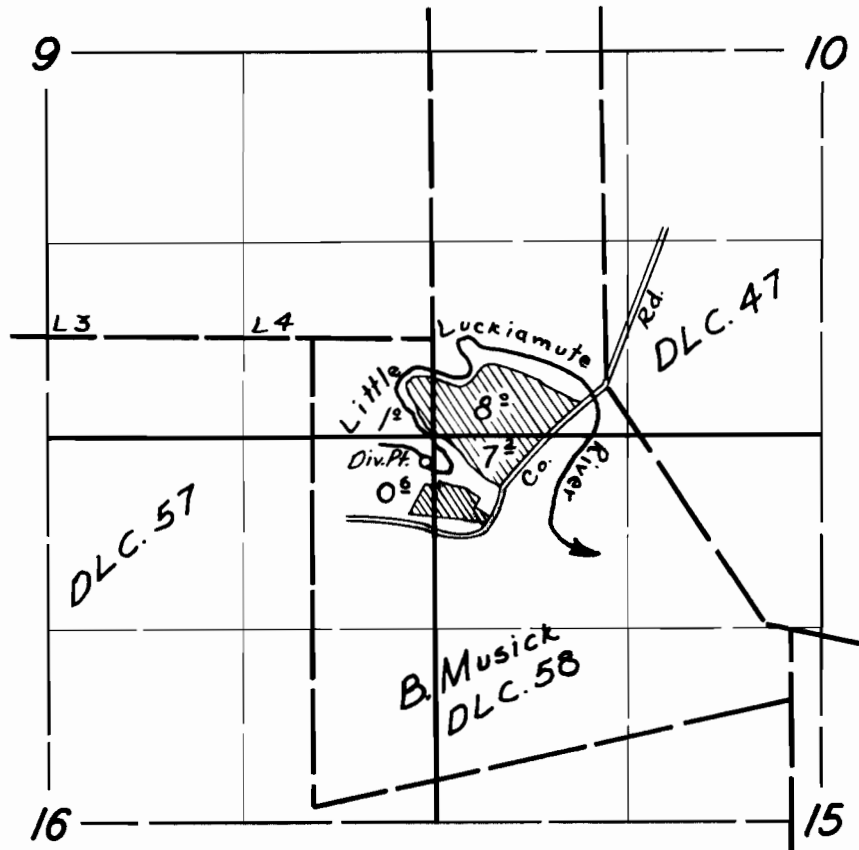

**FINAL PROOF SURVEY**

UNDER

Application No. 26780 Permit No. 21040

IN NAME OF

George Knaupp Jr.

Surveyed 16 Aug. 1956, by R. H. Whitby

DFP-2D-172

RWT