


T. 2 S., R. 2 W., W. M.

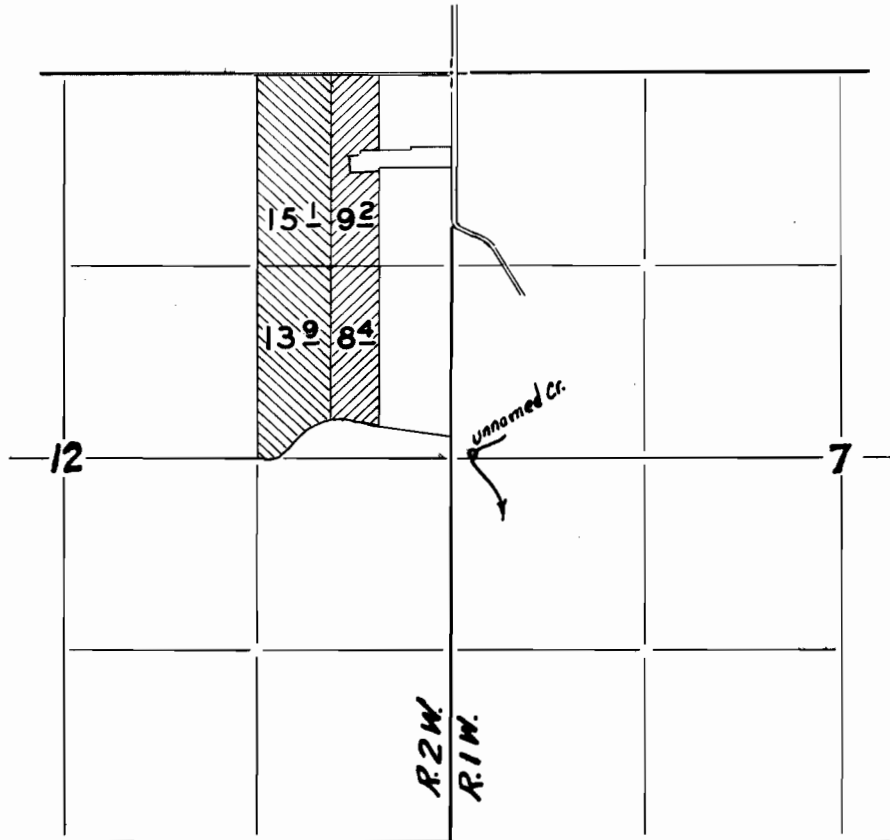


FINAL PROOF SURVEY

UNDER

26859

21093

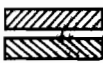Application No. 27890 Permit No. 21968. 

IN NAME OF

FRED B. GRABHORN

Surveyed 5 - 10. 1956 by M. BISH