


1

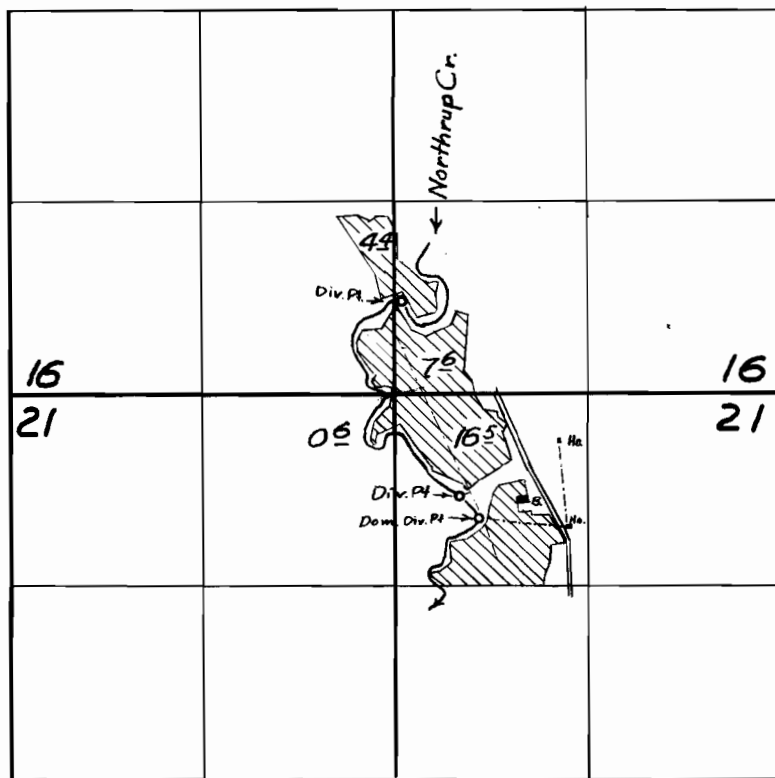

FINAL PROOF SURVEY

UNDER

Application No. 25896 Permit No. 21134
IN NAME OF

Fred A. Stinchfield

Surveyed 15 Aug. 1956 by Tm. Bish