


T.1S., R.2W., W.M.

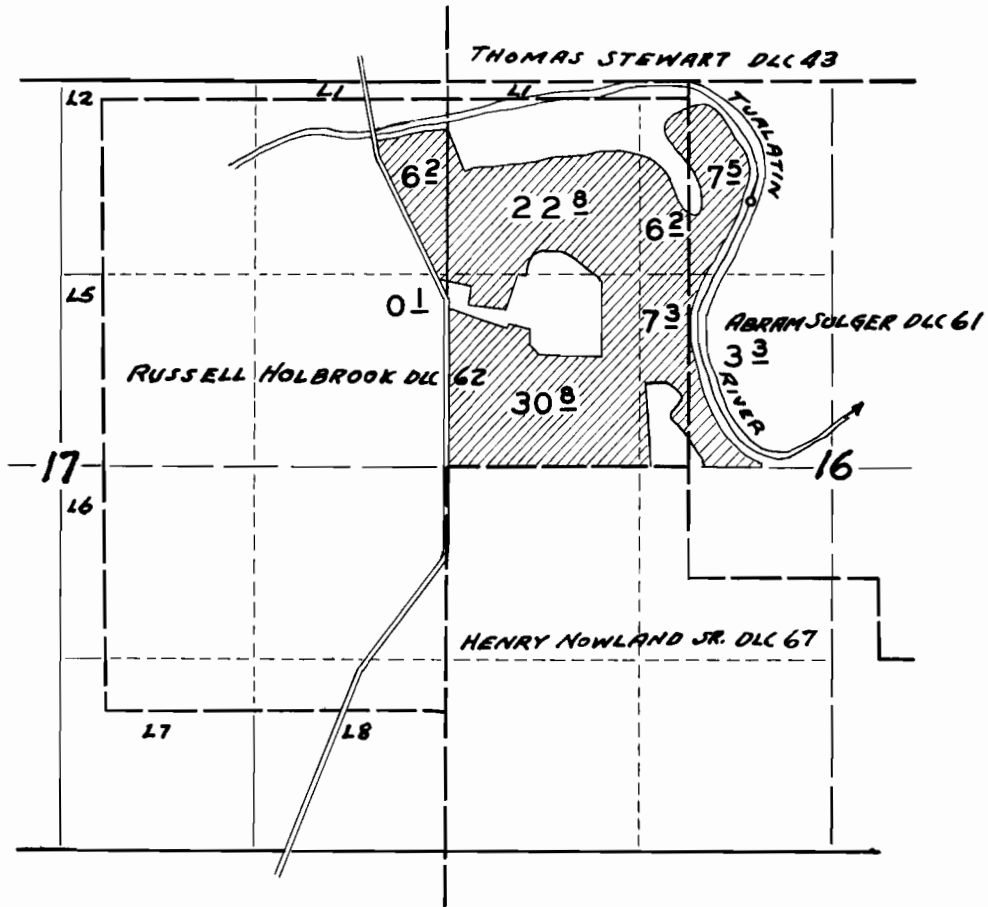

FINAL PROOF SURVEY

UNDER

Application No. 2694 | Permit No. 21166

IN NAME OF

ALBERT GREENER

Surveyed 4 - 19 1956, by M. BISH