


T. 9S. R. 5W. W.M.

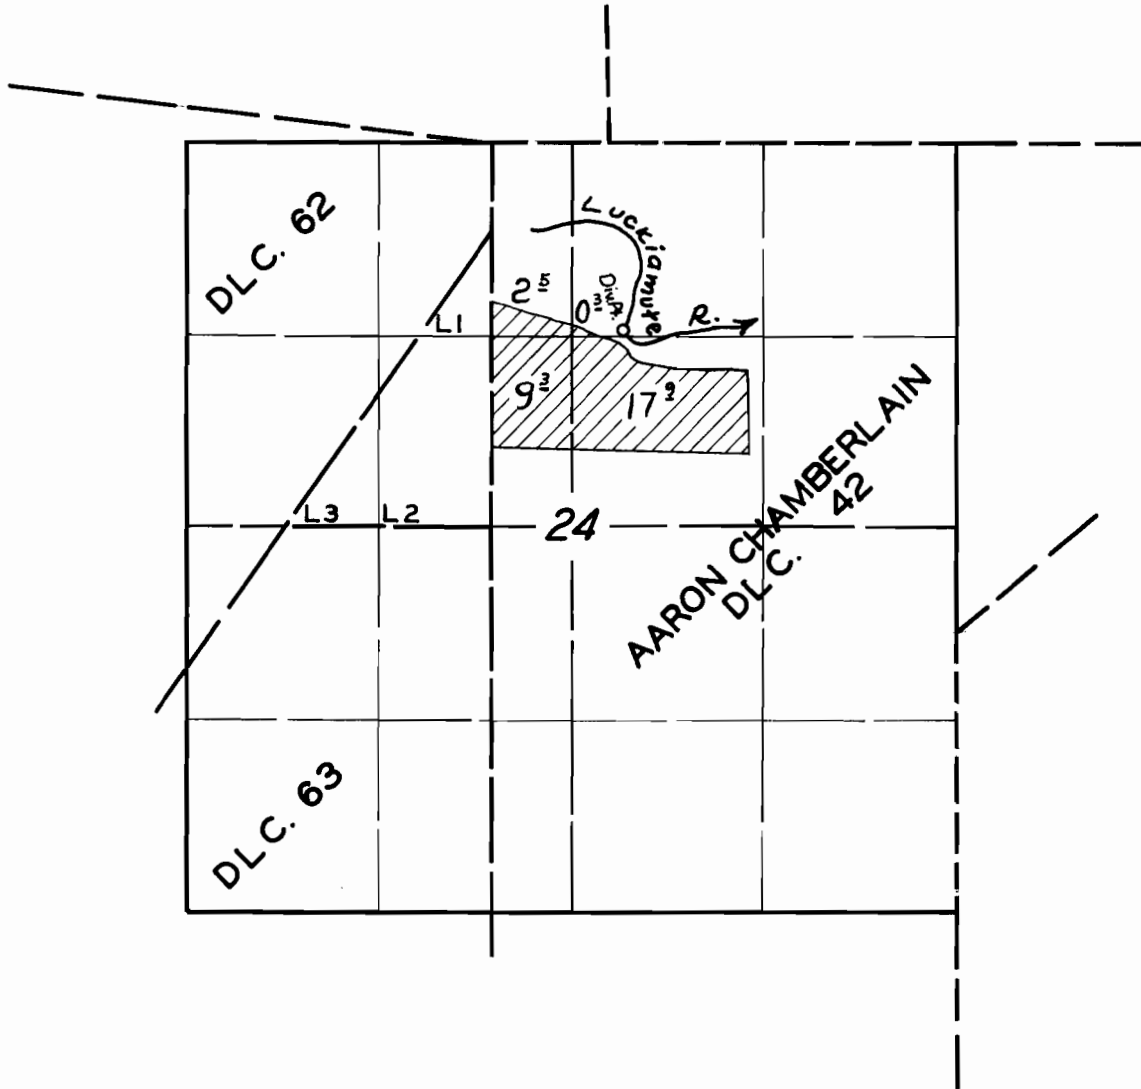

FINAL PROOF SURVEY
UNDER

Application No. **26954** Permit No. **21176**
IN NAME OF

JOHN C. OR DOROTHY E. HEFFLEY

Surveyed 15 AUG. 1956, by R.H. WHITBY