


T.2 S. R.3 E.W.M.

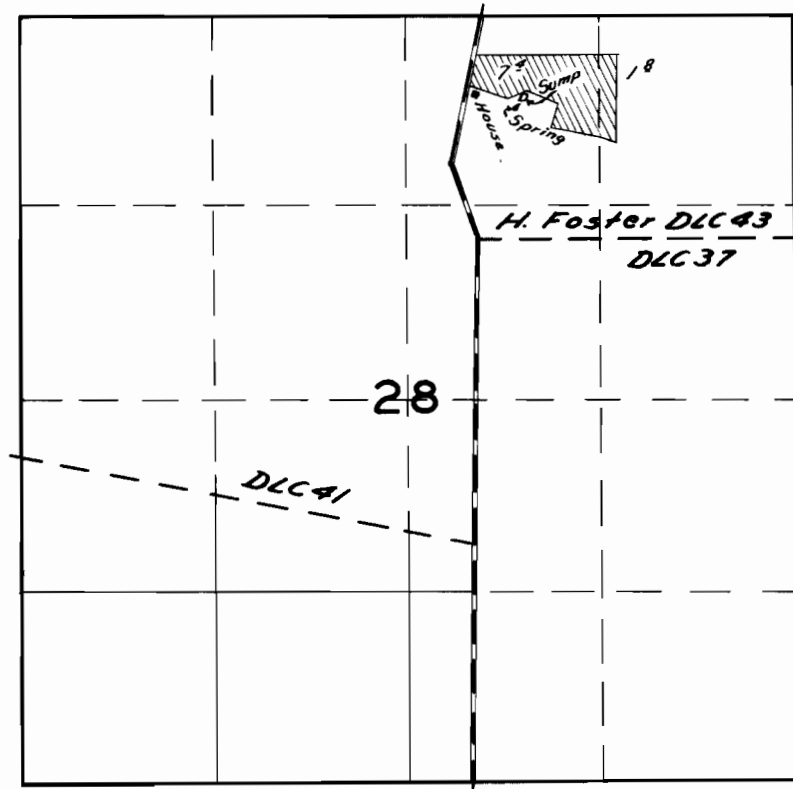

FINAL PROOF SURVEY
UNDER

Application No. 27014 Permit No. 21216.....
IN NAME OF

TENNY MOSTUL

Surveyed June 30 1956, by R.H. Whitty.....

DFK-10-165