


T. 1 N., R. 2 W., W. M.

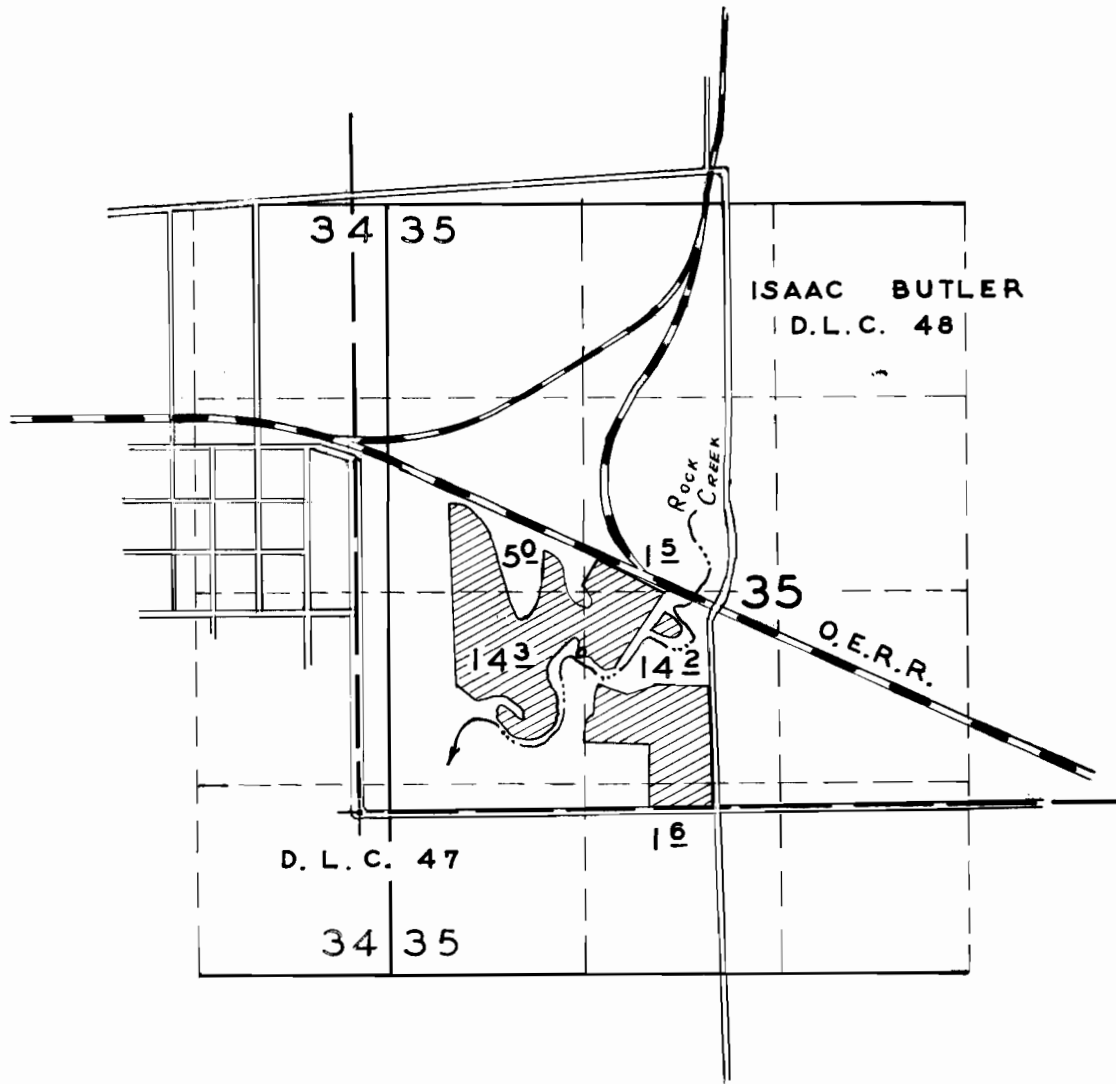

**FINAL PROOF SURVEY**

UNDER

Application No. 27055 Permit No. 21221  
IN NAME OF

DERRELL E. BROWN

Surveyed 4 - 10 1956, by M. BISH