


T. 6 N R. 2 W W. M.

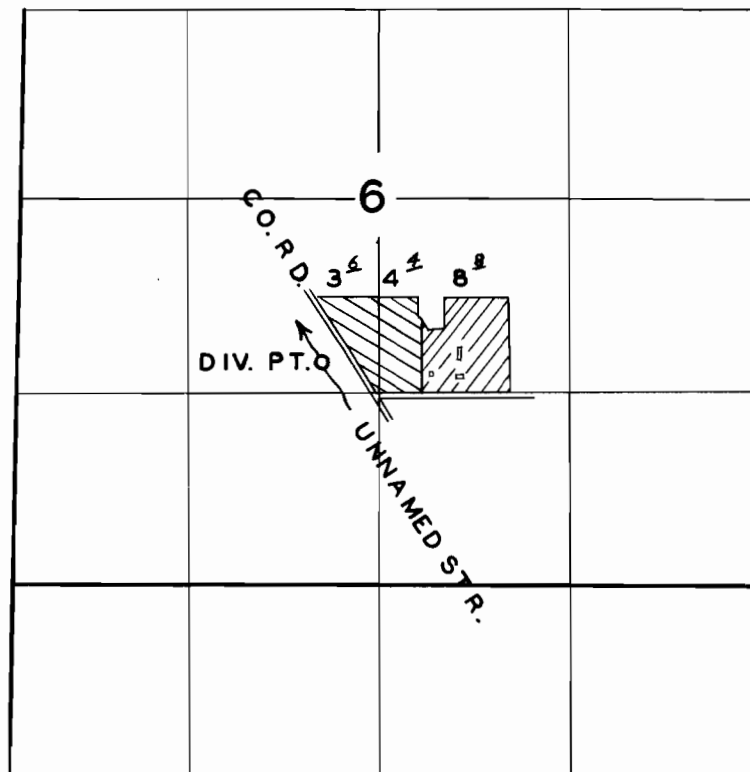

FINAL PROOF SURVEY

UNDER

25949

20334



Application No. 27126 Permit No. 21222



IN NAME OF

FRANK G. TYRELL

Surveyed AUG. 23 1956, by R. H. WHITBY

1956 V

W. J. 9