


T.2S., R.2W., W.M.

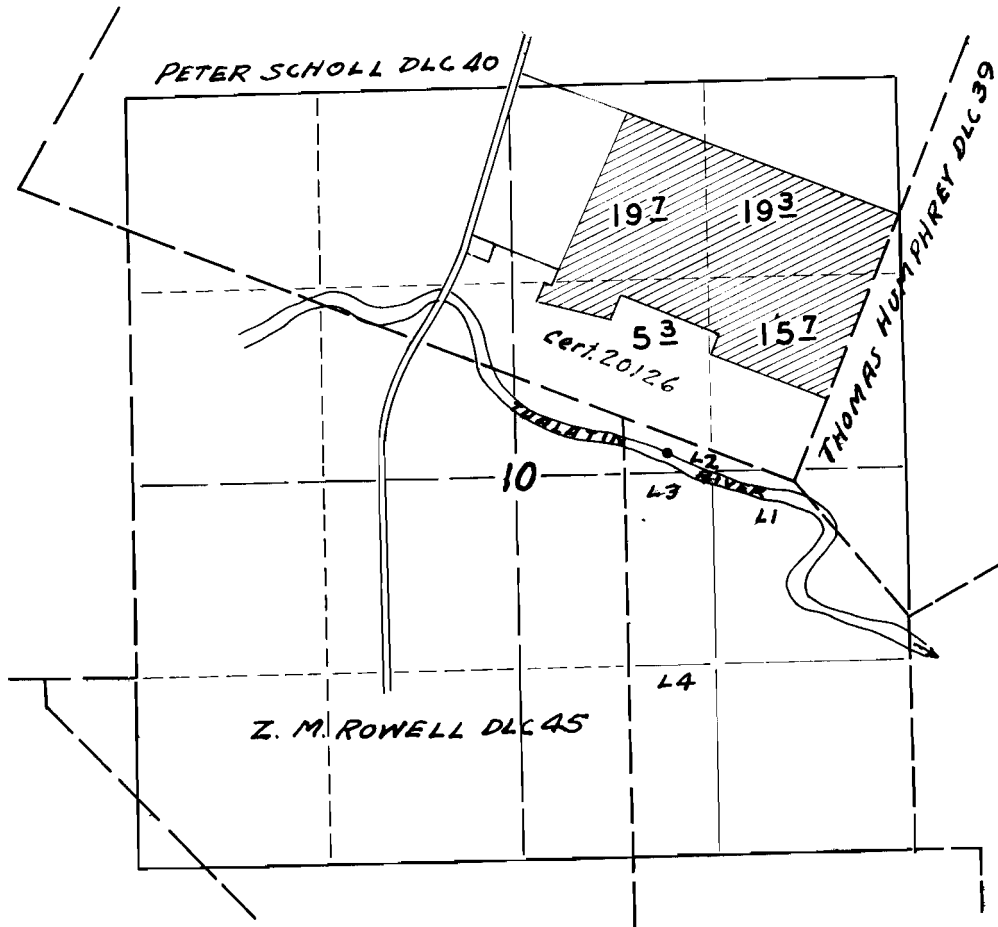

**FINAL PROOF SURVEY**

UNDER

Application No. 24600 Permit No. 21231  
IN NAME OF

**BRACEY NEAL**

Surveyed 4 - 27 1956, by M. BISH