


T. 7 S. R. 2 W. W. M.

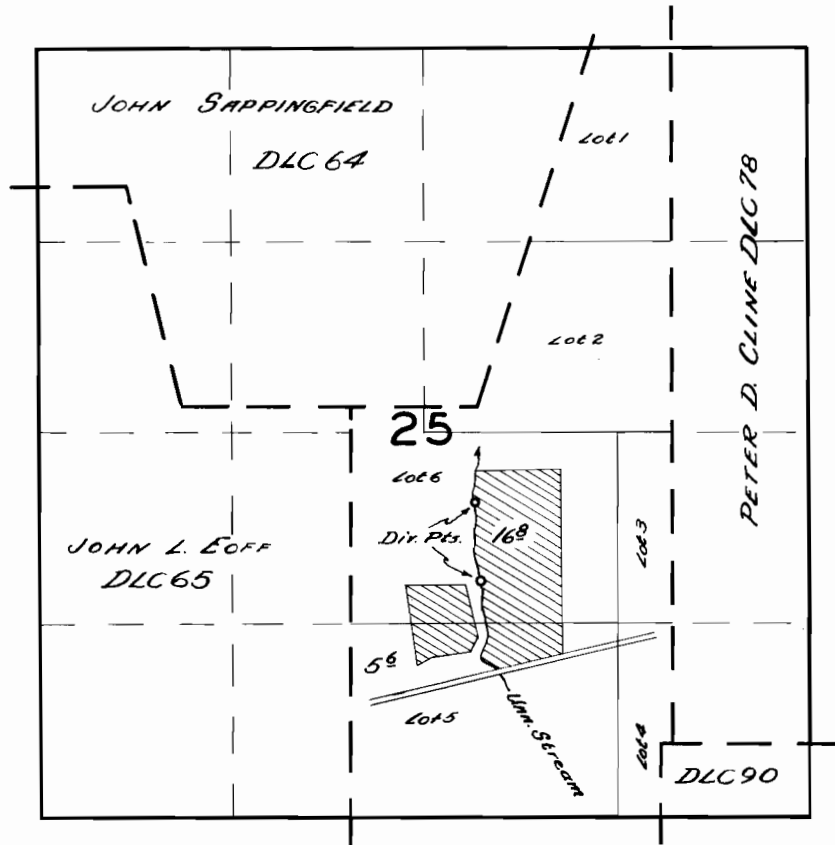

**FINAL PROOF SURVEY**

UNDER

Application No. 27021 Permit No. 21266

IN NAME OF

HERMAN KLEEN

Surveyed May 22 1956, by R.H. Whitby