


T.2 N., R. 4 W., W.M.

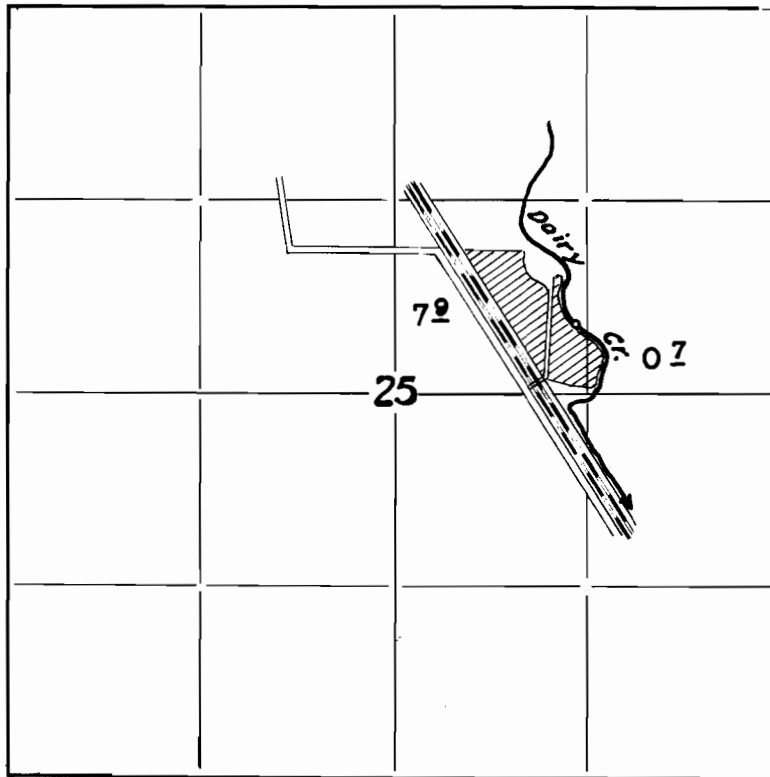

FINAL PROOF SURVEY

UNDER

Application No. 25684 Permit No. 21307

IN NAME OF

FRED CREPS

Surveyed 4-12 1956, by R. H. WHITBY