


T. 4 N. R. 3 W. W. M.

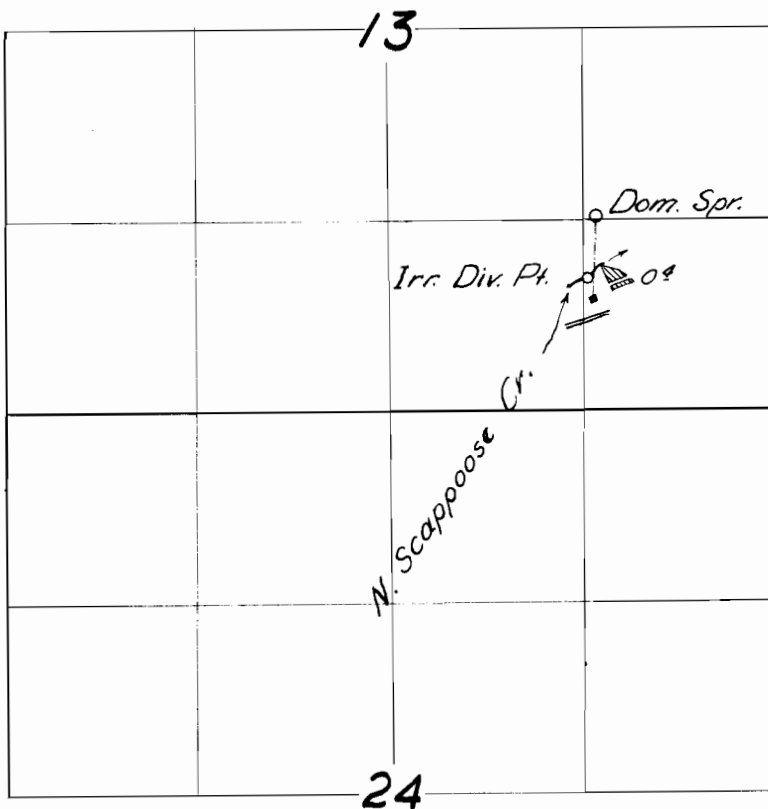

FINAL PROOF SURVEY
UNDER

Application No. 27097 Permit No. 21323

IN NAME OF

E. C. FETZNER

Surveyed 15 July 1956, by PA Whiteley