


T. 1 S., R. 2 W., W.M.

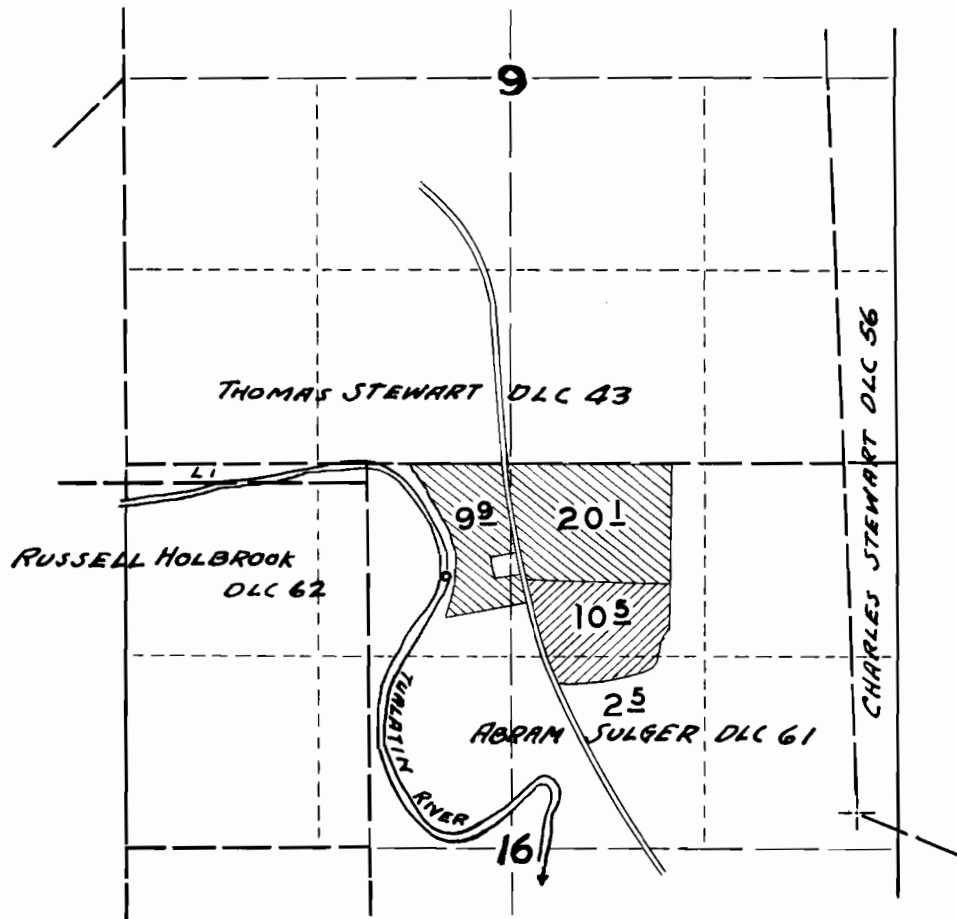

**FINAL PROOF SURVEY**

UNDER

26648

20873

Application No. 27123 Permit No. 21336

IN NAME OF

LENNOX BLATCHFORD

Surveyed 4 - 18 1956, by M. BISH

