


T. 3 N. R. 2 W. W. M.

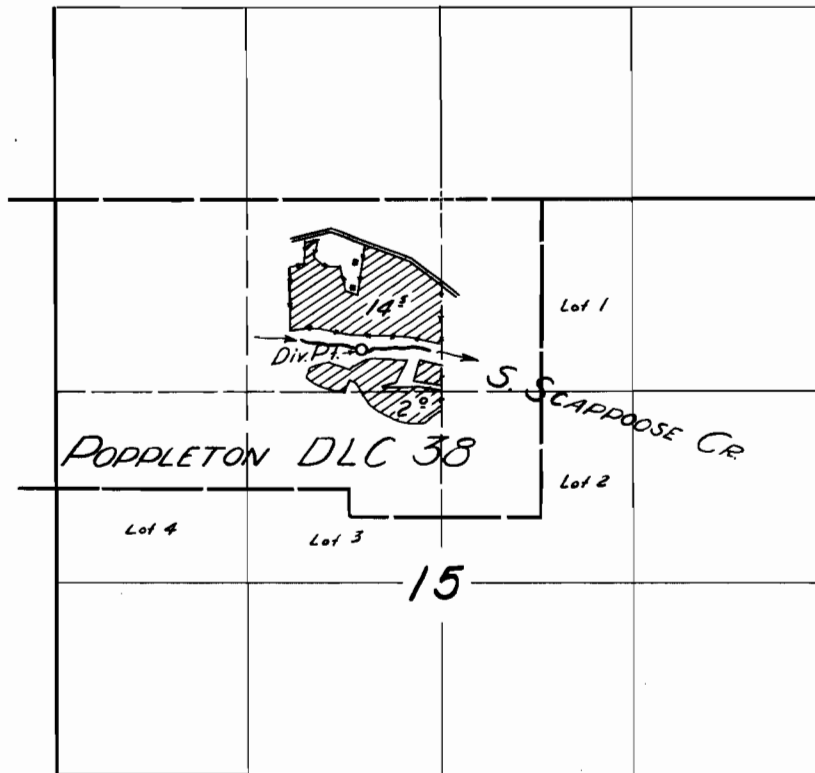

FINAL PROOF SURVEY

UNDER

Application No. 27153 Permit No. 21355

IN NAME OF

WILLIAM M. BEASTON

Surveyed 31 July 1956, by C. A. H. [Signature]