


T.2N., R.2W., W.M.

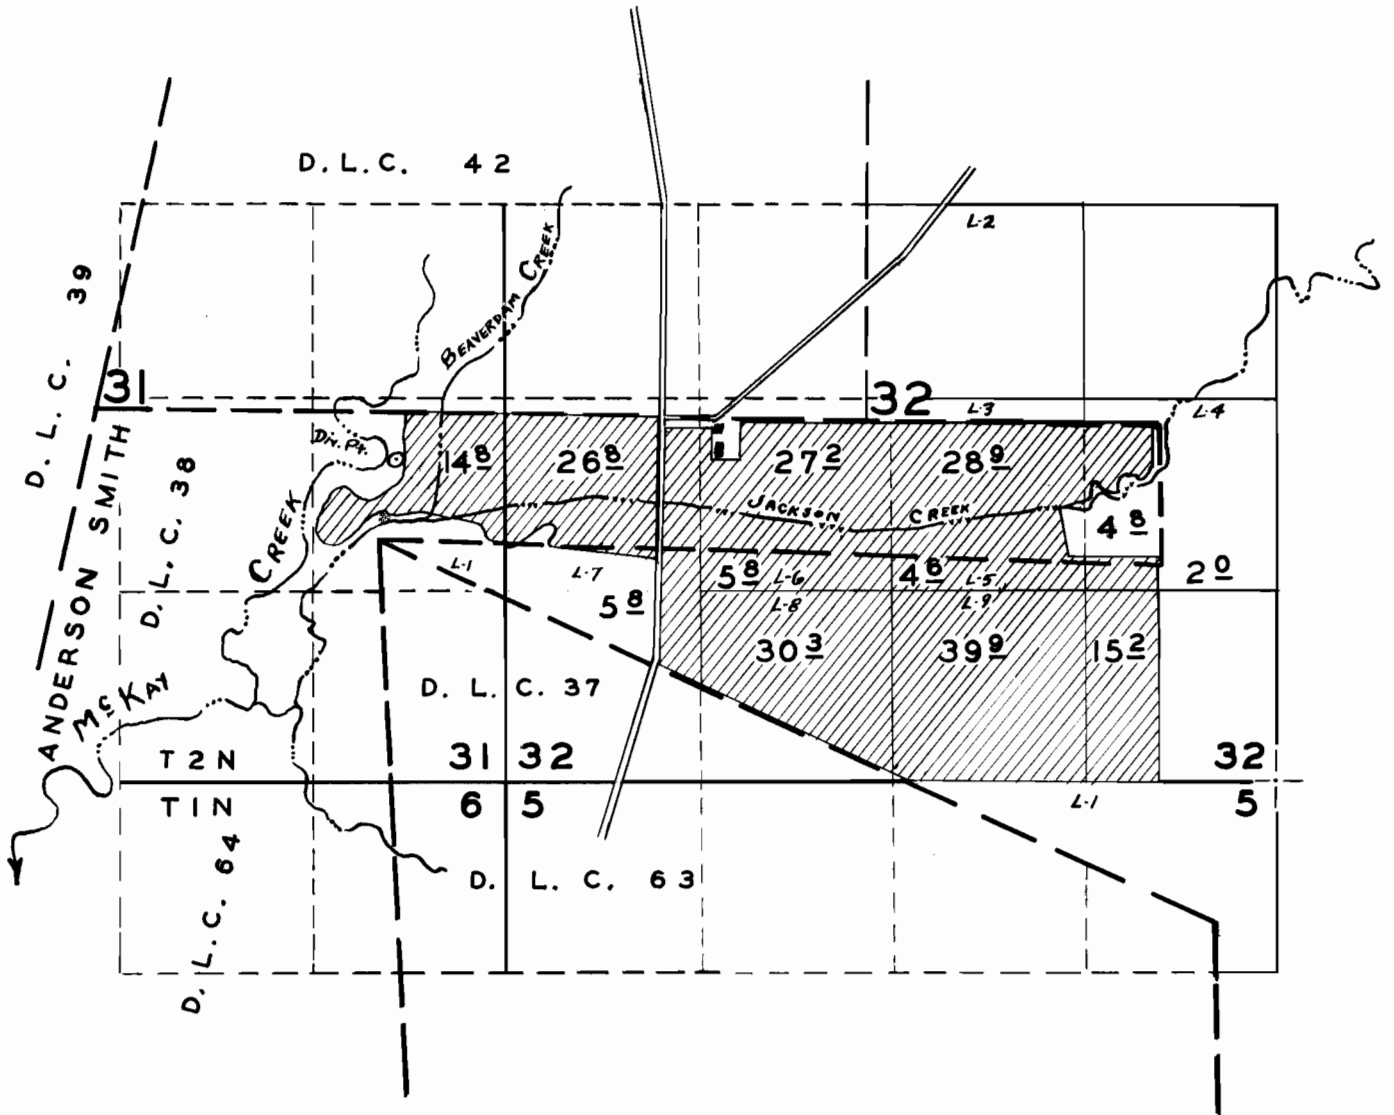

FINAL PROOF SURVEY

UNDER

Application No. 27171 Permit No. 21368

IN NAME OF

WALTER VANDERZANDEN

Surveyed 4 - 12 1956, by M. BISH