


T. 6S. R. 1E. W.M.

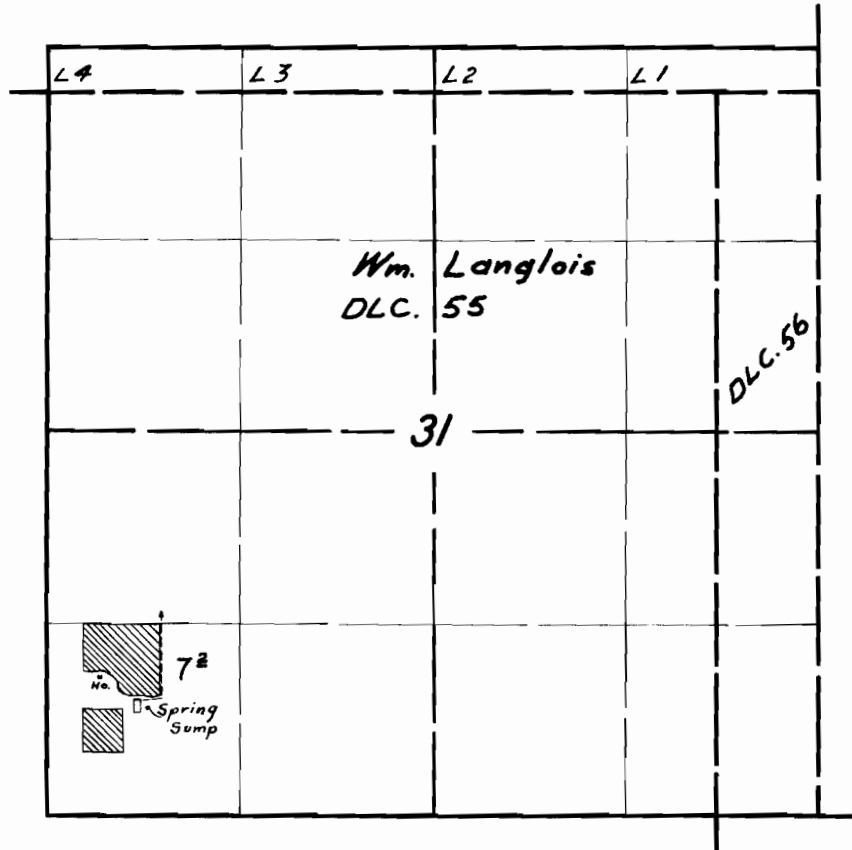

FINAL PROOF SURVEY

UNDER

Application No. 27350 Permit No. 21534

IN NAME OF

Albert E & Mae Reid

Surveyed 19 July 1956, by M. Bish

DFN-1D-124

Bish