


T.1S.R.3W. W.M.

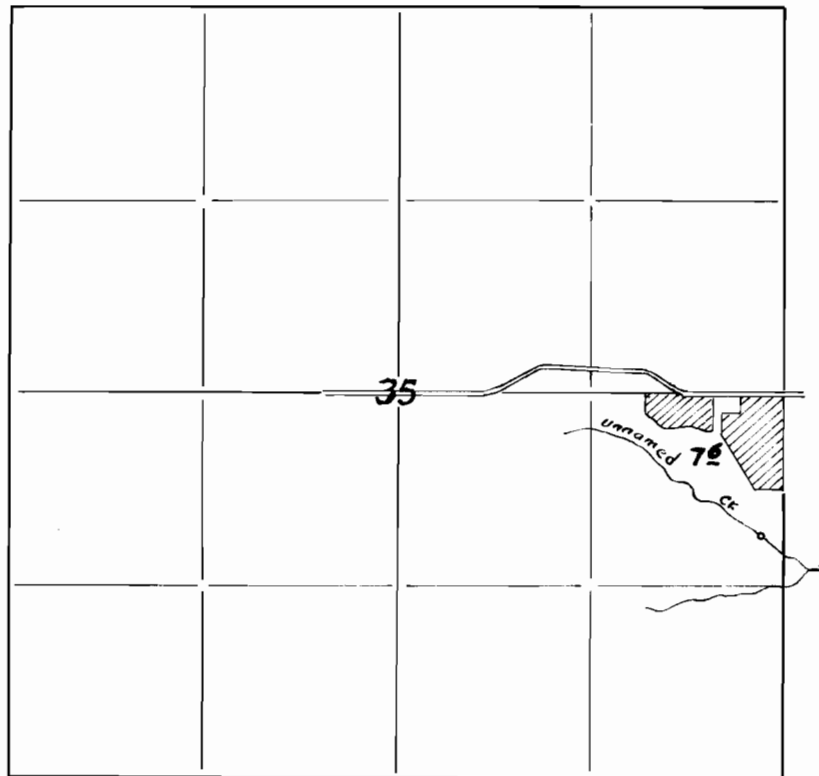

FINAL PROOF SURVEY

UNDER

Application No. 27433 Permit No. 21600

IN NAME OF

..... HENRY PETERS

Surveyed 5-1-1956, by R.H. WHITBY.