


T. 2 S., R. 2 W., W.M.

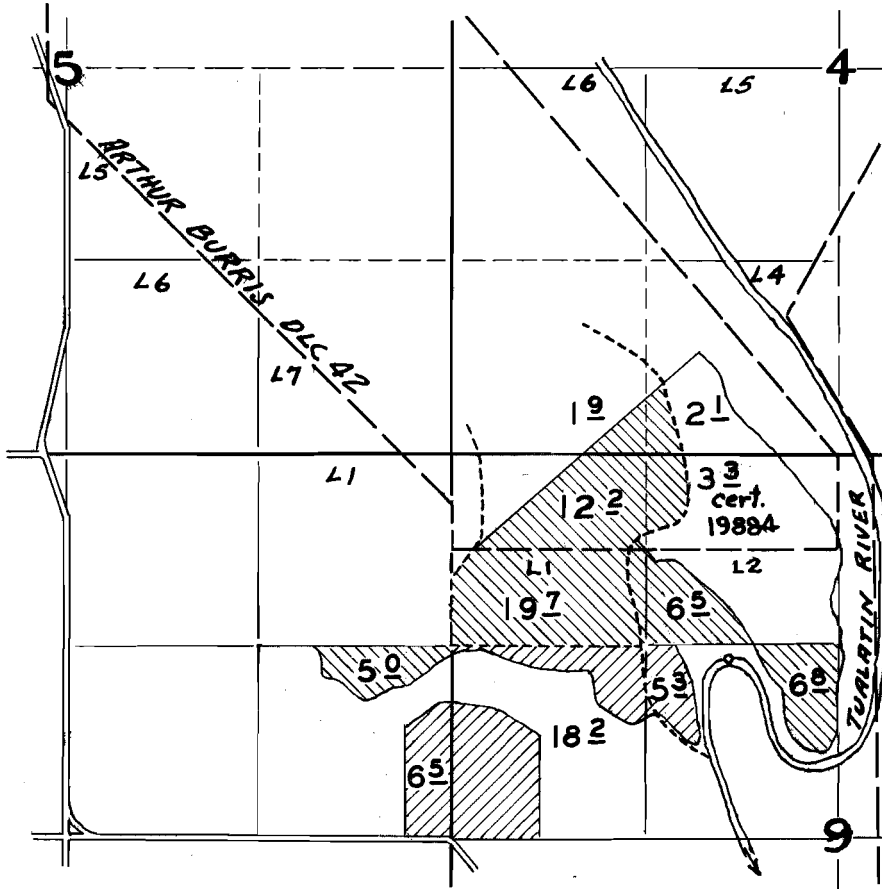

FINAL PROOF SURVEY

UNDER

24879

19574

Application No. 27594

Permit No. 21739



IN NAME OF

JAMES H. BROWN

Surveyed 5 - 2 1956 by M. BISH