


T.2 N. R.3W. W.M.

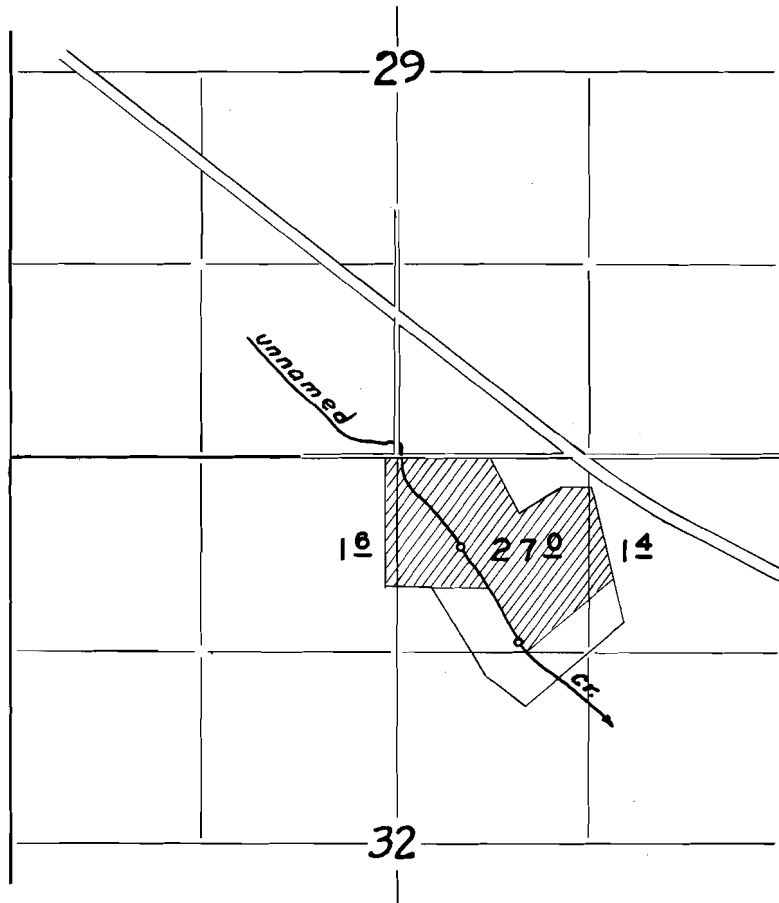

FINAL PROOF SURVEY

UNDER

Application No. 27639 Permit No. 21770

IN NAME OF

WILLIAM RUFENER

Surveyed 4 - 18 1956, by R.H. WHITBY.