


T.10S. R.2W.W.M.

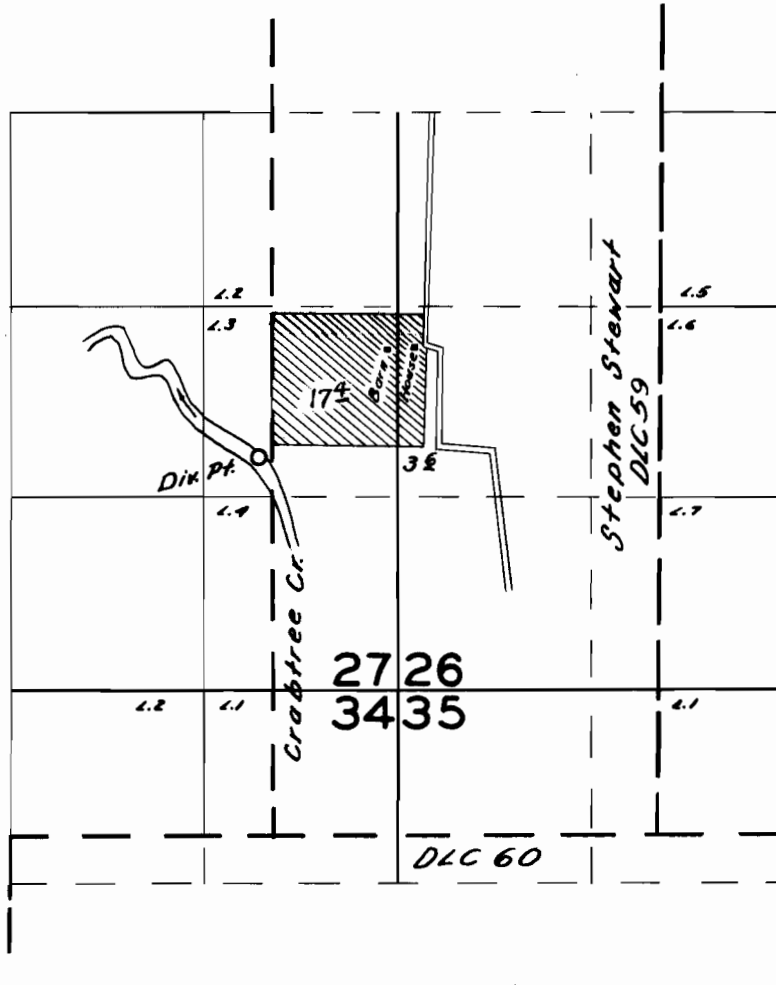

FINAL PROOF SURVEY

UNDER

Application No. 27666 Permit No. 21786
IN NAME OF

Lloyd & Marian Kessell

Surveyed July 24 1956, by C.O. Bartels