


T. 1 N., R. 2 & 3 W., W.M.

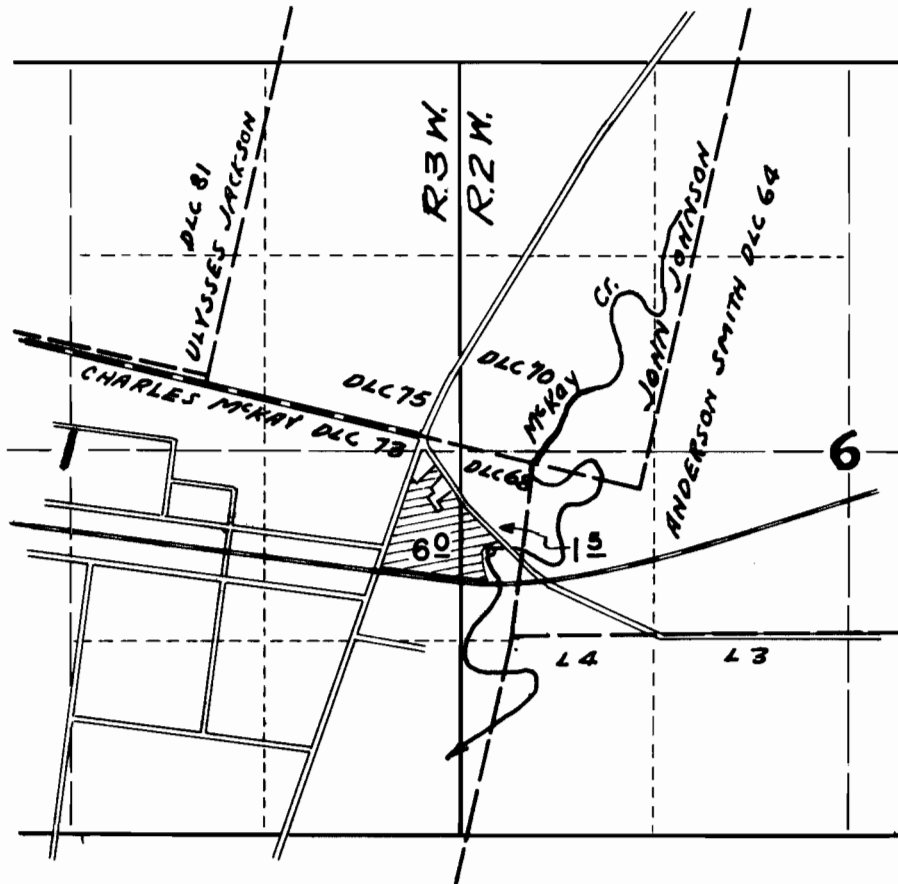

**FINAL PROOF SURVEY**

UNDER

Application No. 27669 Permit No. 21789

IN NAME OF

PAUL W. VOLPP

Surveyed 4 - 11 1956, by M. BISH