


T. 7 S. R. 2 W. W.M.

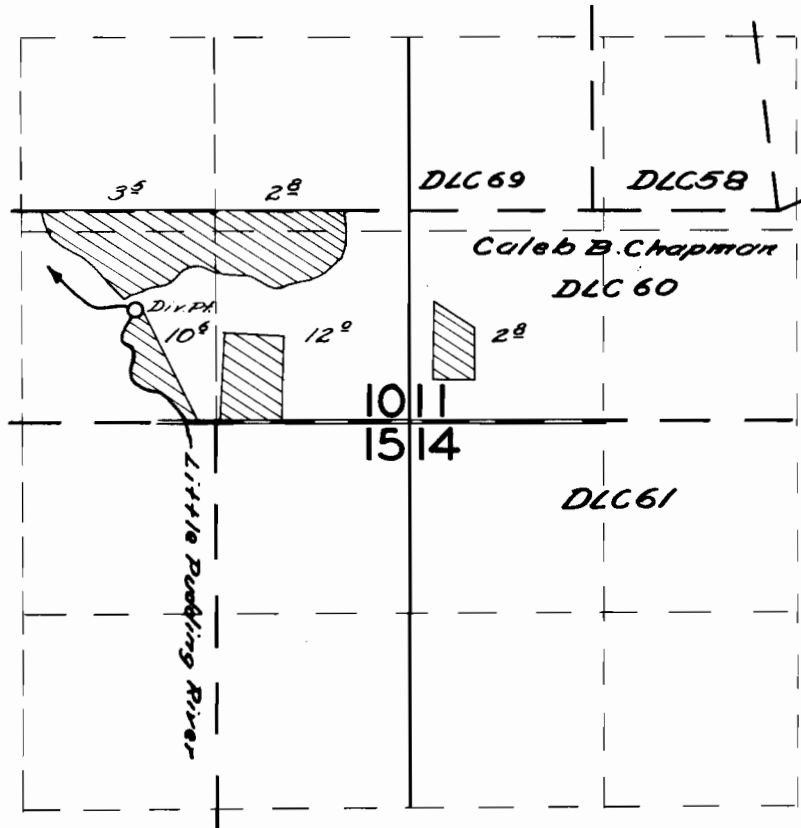

FINAL PROOF SURVEY

UNDER

Application No. *27691* Permit No. *21801*

IN NAME OF

Richard Miller

Surveyed *May 22*, 19*56*, by *R. H. Whitby*