


T. 4S. R. 2W. W.M.

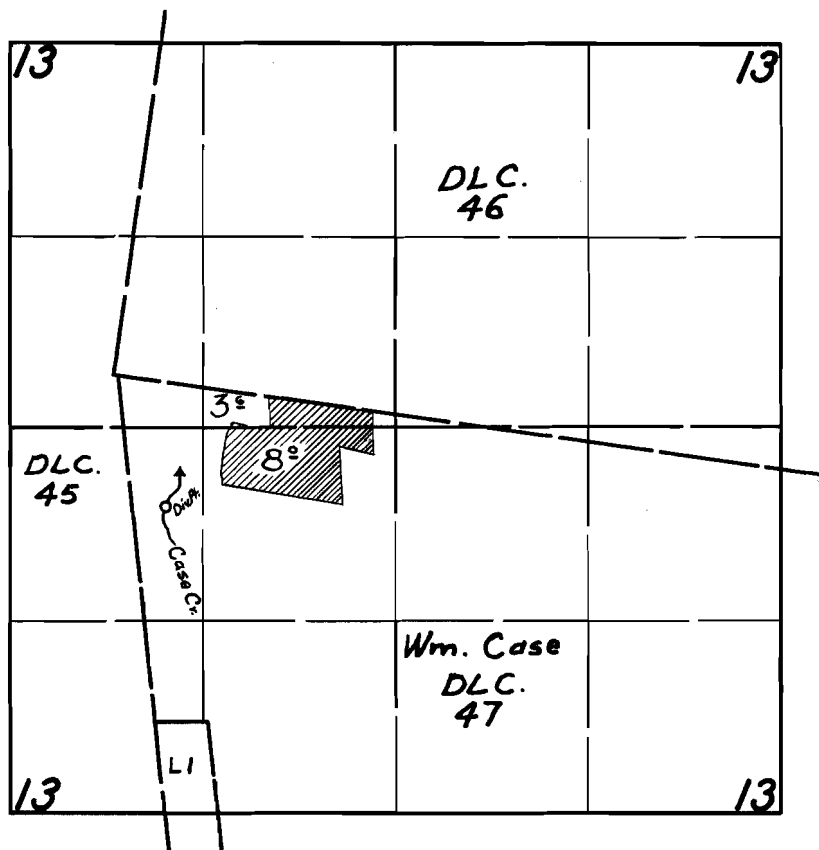

FINAL PROOF SURVEY

UNDER

Application No. 27840 Permit No. 21896

IN NAME OF

Ralph Yergen

Surveyed 21 Sept. 1956, by M. Bish

DFN-2D-96

AKW