


T.2S., R.2W., W.M.

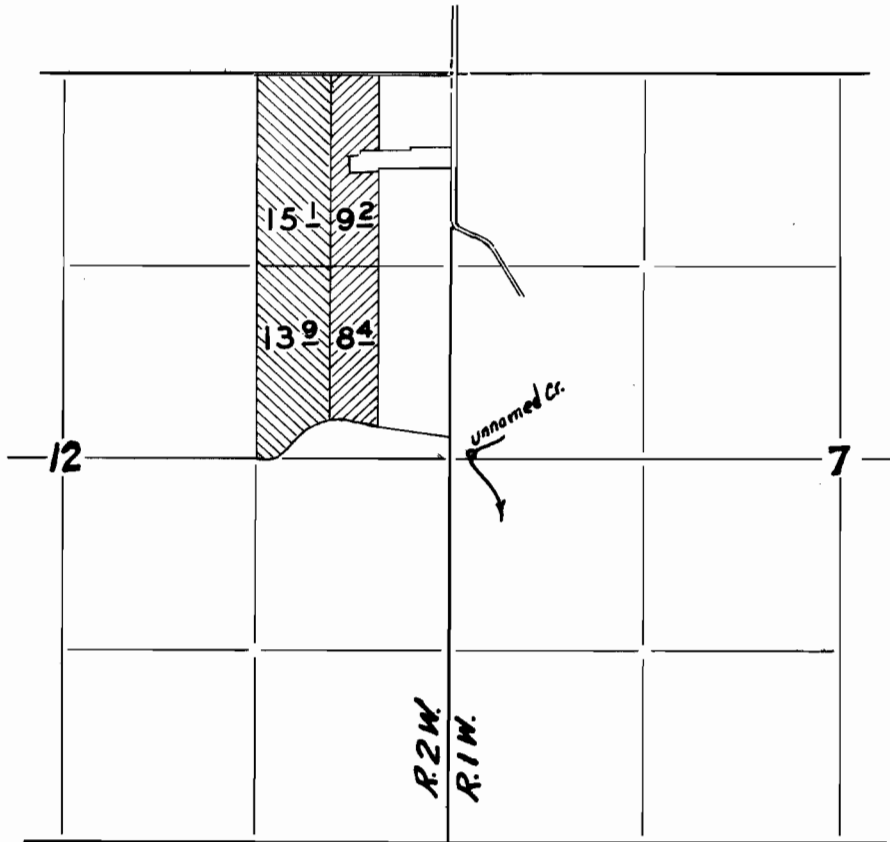

FINAL PROOF SURVEY

UNDER

26859

21093

Application No. 27890 Permit No. 21968

IN NAME OF

FRED B. GRABHORN

Surveyed 5 - 10 1956 by M. BISH