


T. 3 N. R. 2 W. W. M.

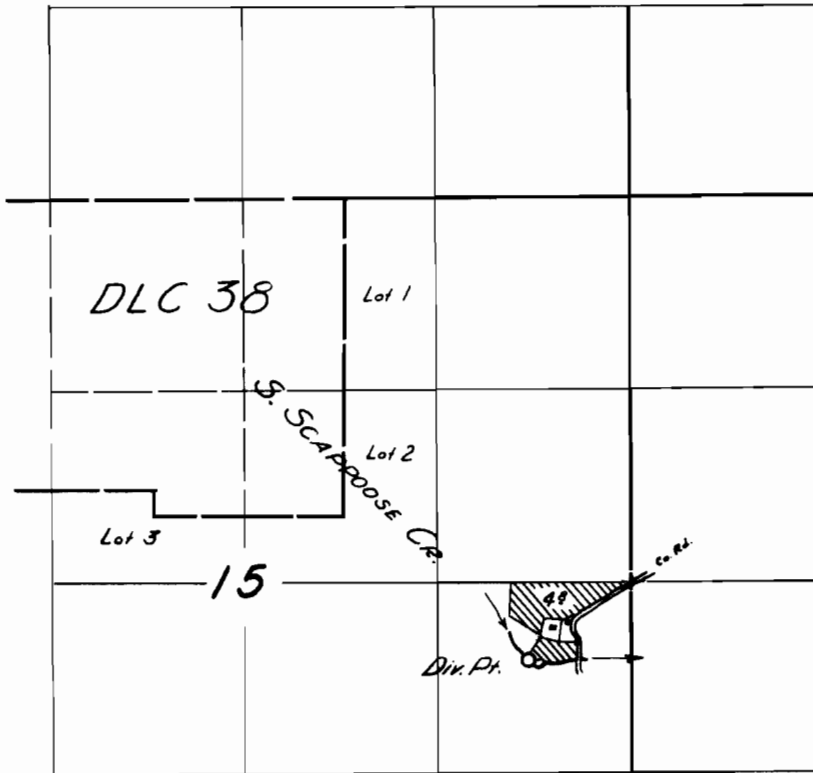

FINAL PROOF SURVEY
UNDER

Application No. 27930 Permit No. 21996

IN NAME OF

ADOLPH ZEISMAN

Surveyed 31 July 1956, by *[Signature]*