


T. 2S. R. 2E. W.M.

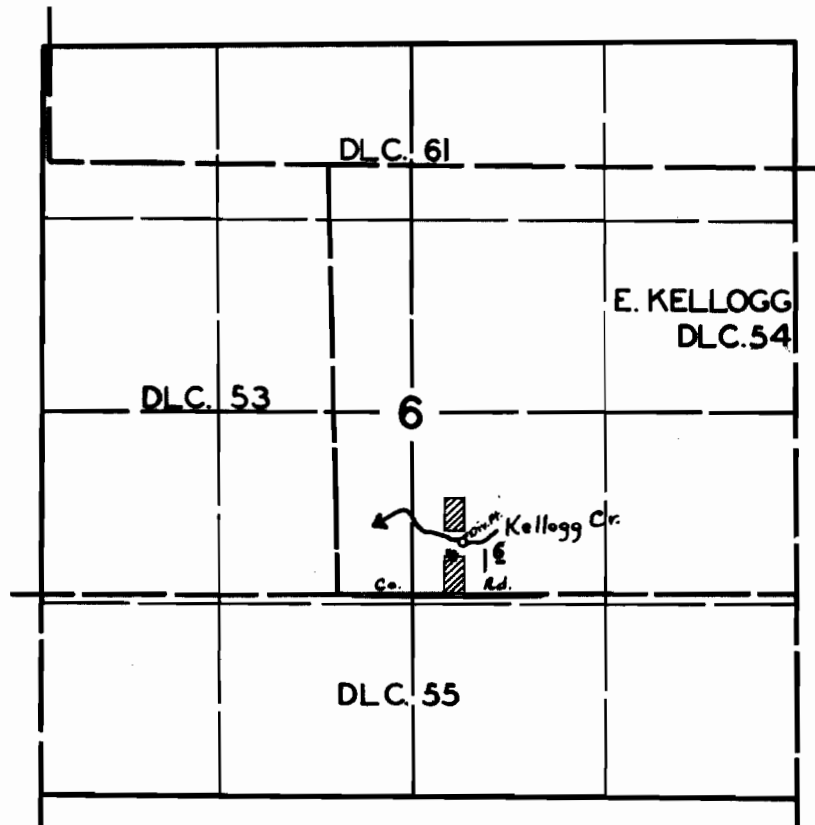

FINAL PROOF SURVEY
UNDER

Application No. 27971 Permit No. 22015

IN NAME OF

L. B. MACNAB

Surveyed 17 May 1956, by M. Bish

65