


T. 1 S., R. 2 W., W.M.

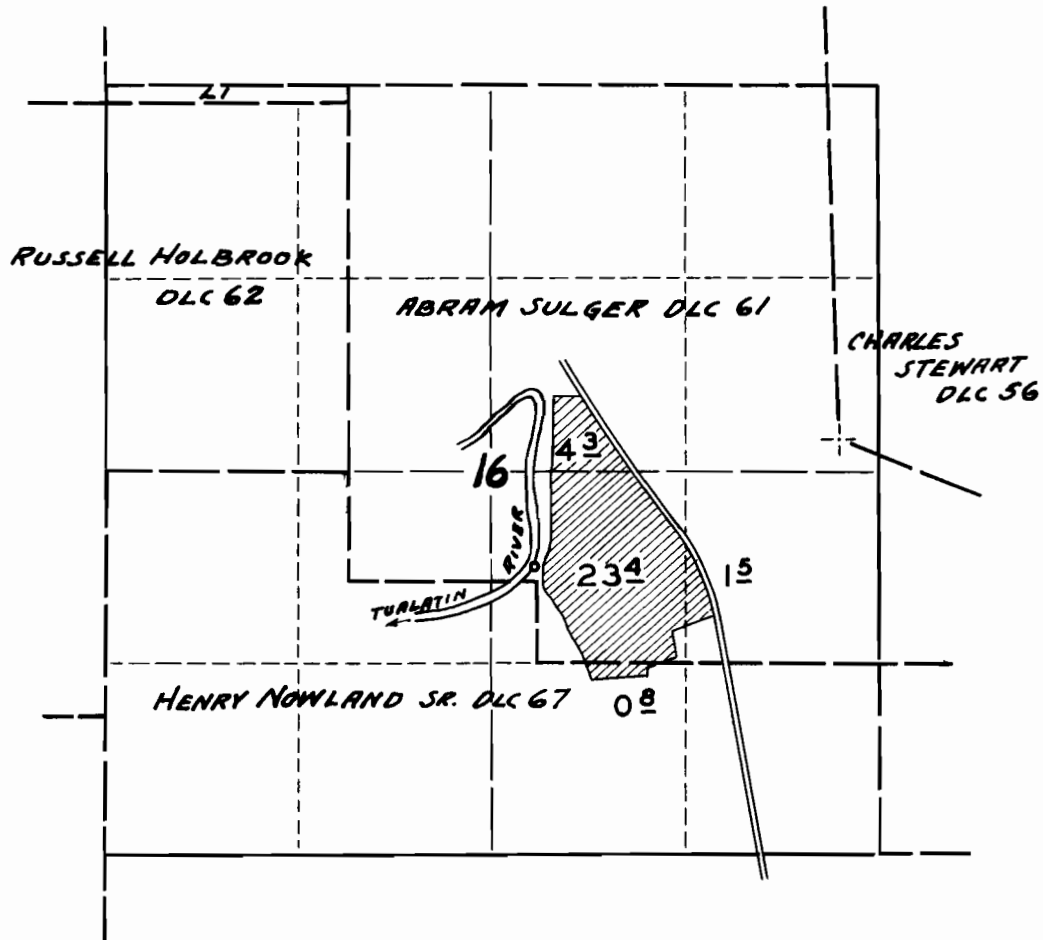

**FINAL PROOF SURVEY**

UNDER

Application No. 27985 Permit No. 22028

IN NAME OF

..... JOHN AMREIN .....

Surveyed 4 - 18 1956, by M. BISH .....