


T. 2 S., R. 1 E., W. M.

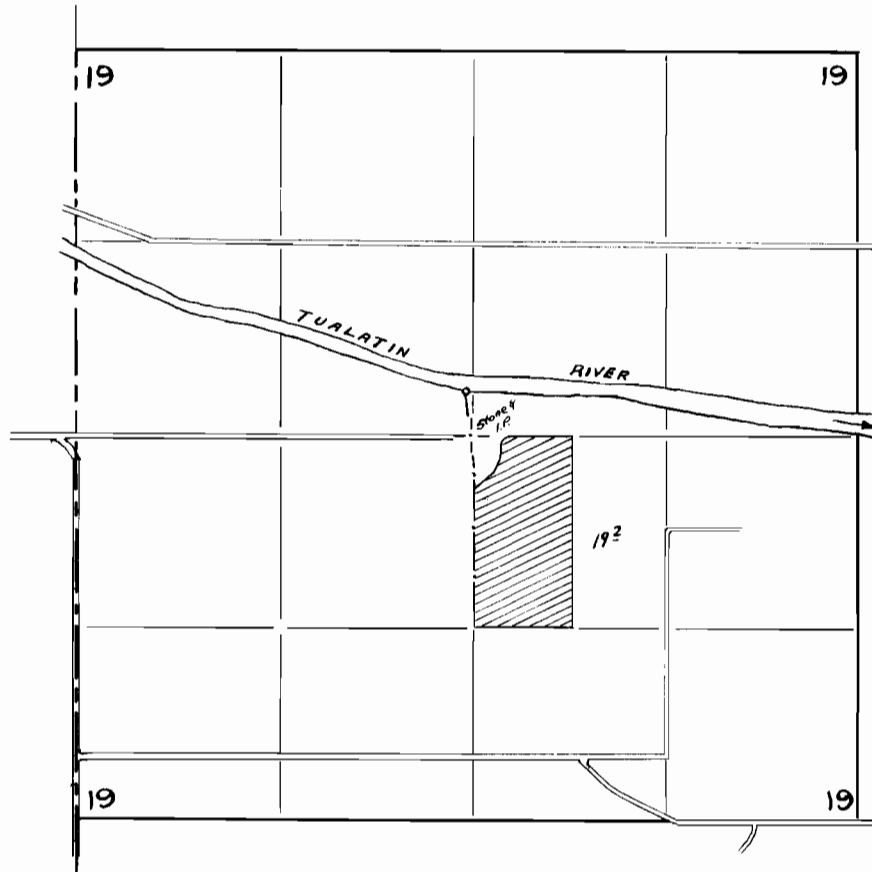

**FINAL PROOF SURVEY**

UNDER

Application No. 27080 Permit No. 22098

IN NAME OF

SCHABER BROTHERS

Surveyed 5-9 1956, by R.D. BEST