


T. 3S. R. 1W. W.M.

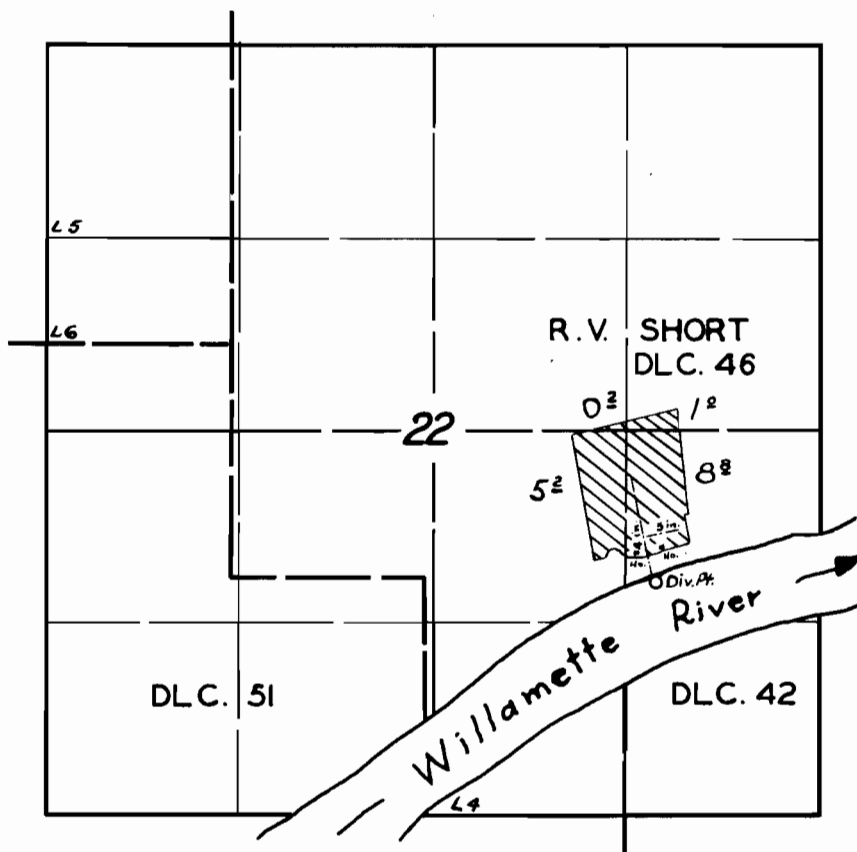

**FINAL PROOF SURVEY**

UNDER

Application No. 28072 Permit No. 22082

IN NAME OF

EARL H. STRANGE

Surveyed 16 MAY 1956, by M. BISH

DFK-2D-60

*R-105*