


T.2 S., R.2 W., W.M.

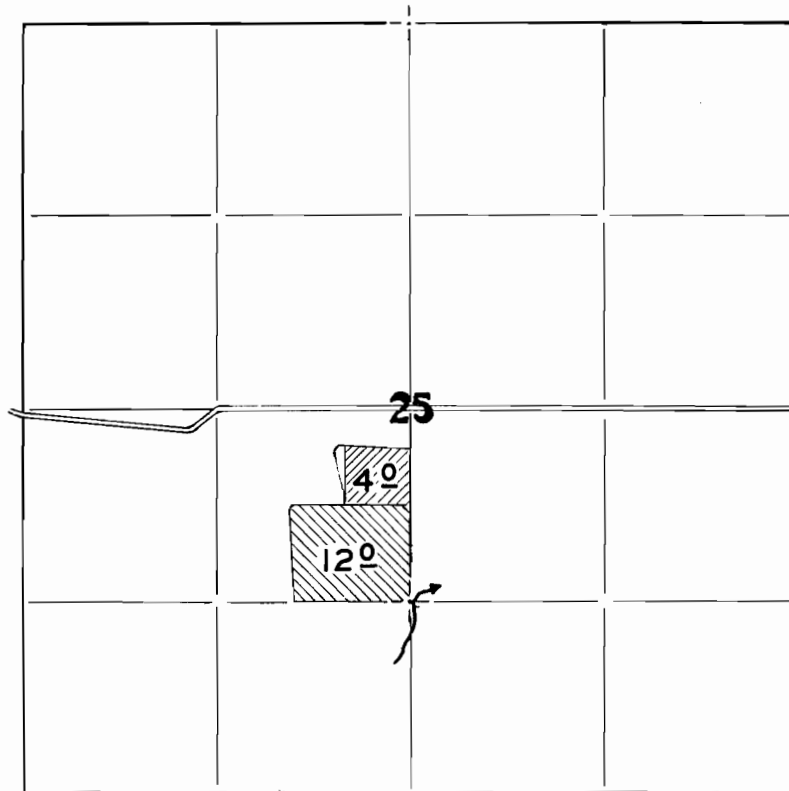


**FINAL PROOF SURVEY**

UNDER

28038

22117

Application No. 26308 Permit No. 20649

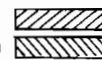

IN NAME OF

E. W. & RUTH M. REHWALT

Surveyed 4-27-1956, by M. BISH