


T. 2 S., R. 2 W., W. M.

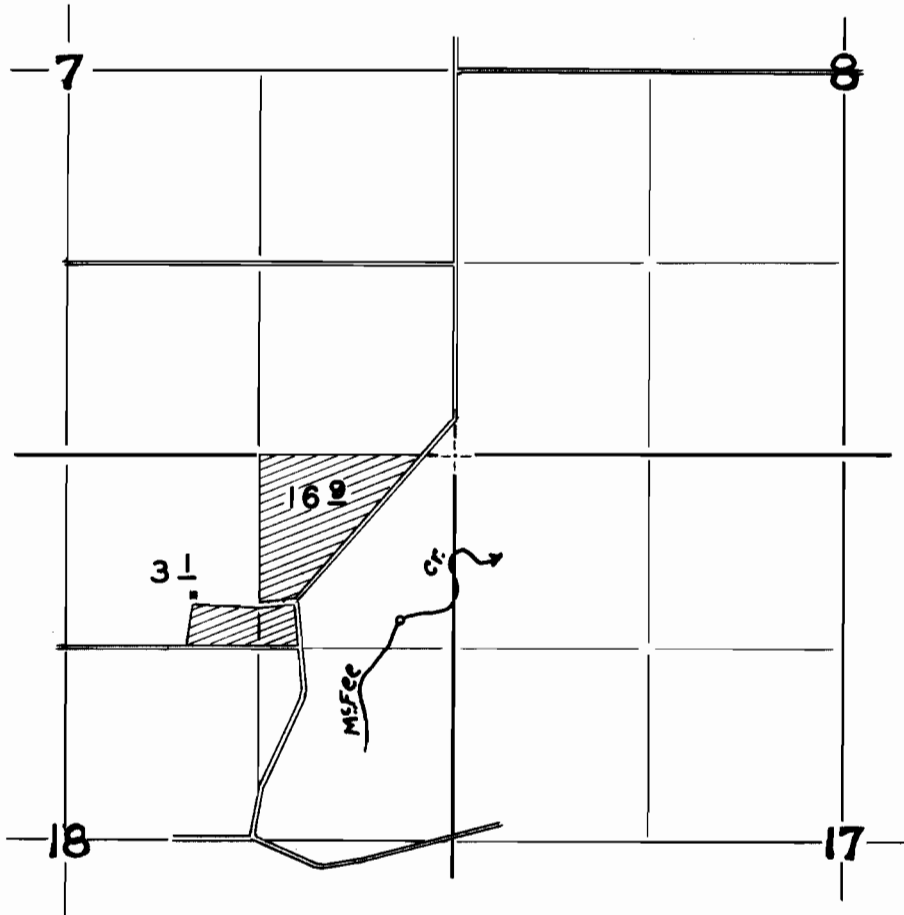

FINAL PROOF SURVEY

UNDER

Application No. 28178 Permit No. 22173

IN NAME OF

EGGER BROTHERS

Surveyed 5 - 3 1956, by M. BISH