


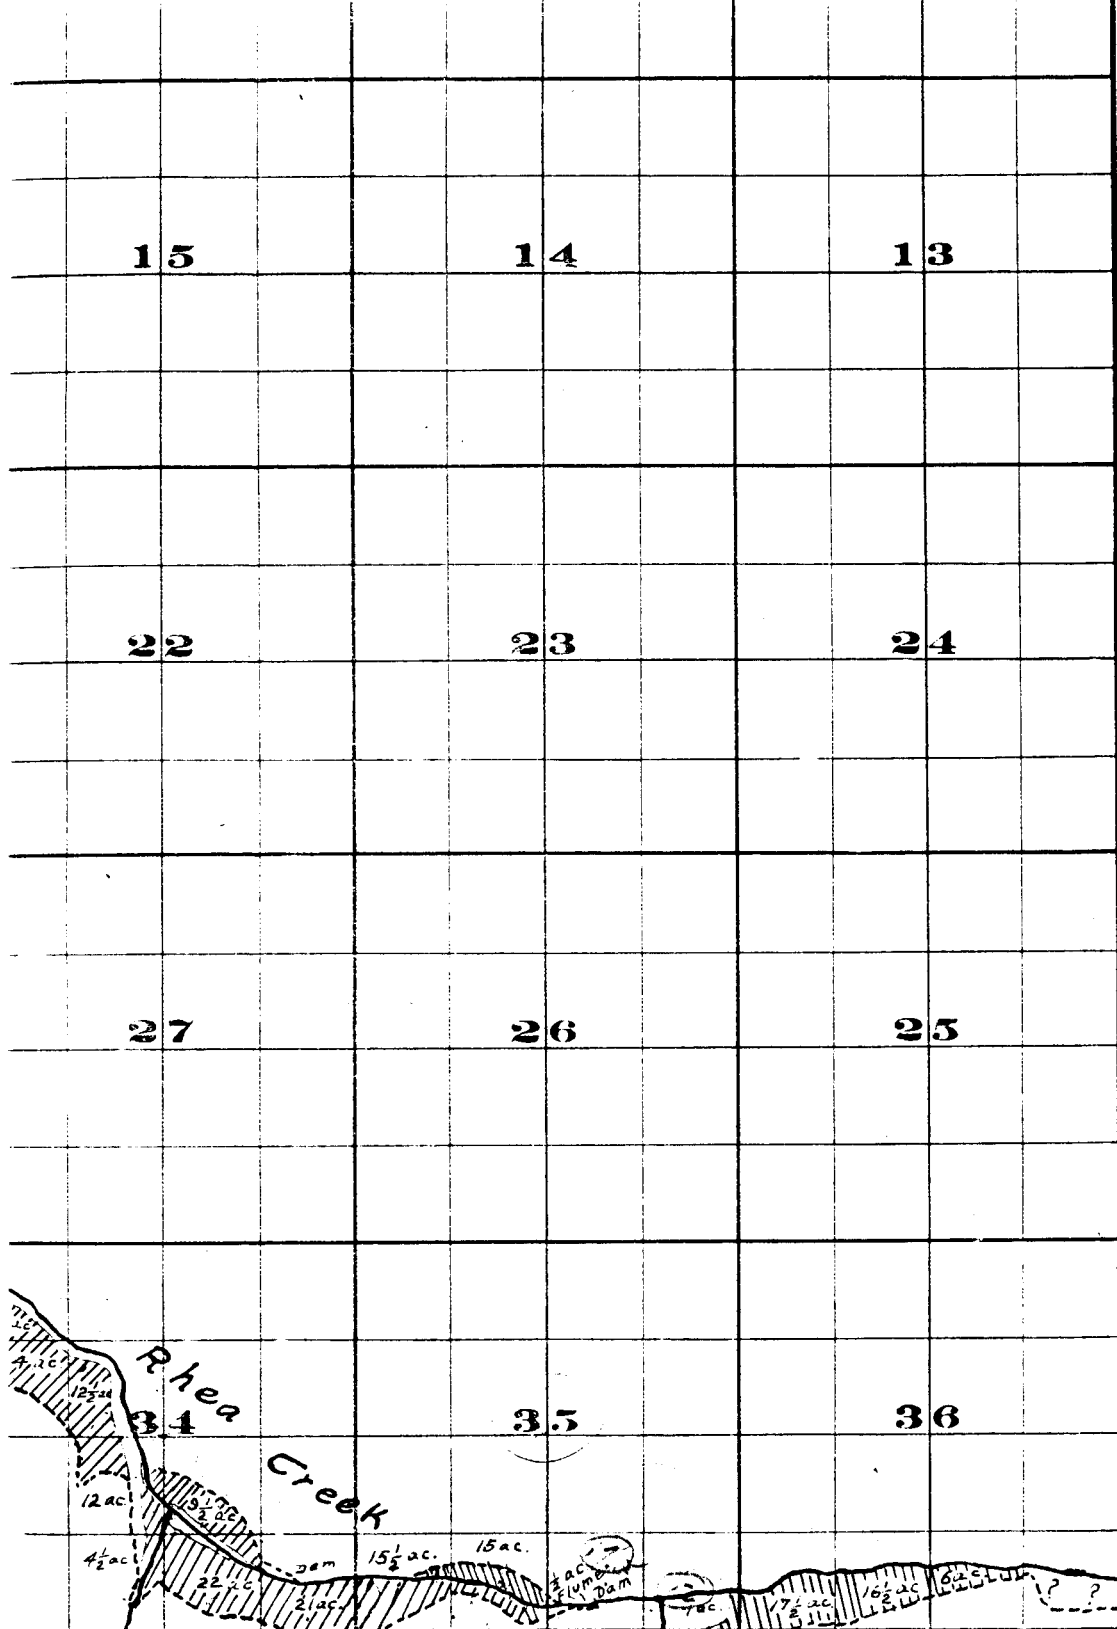

FROM OFFICE OF THE STATE ENGINEER, SALEM, OREGON

July 1909


July 1909

Willow Creek Adjudication


3 S. 25 E.

Part 4 S. 25 E.

Township 3 S.

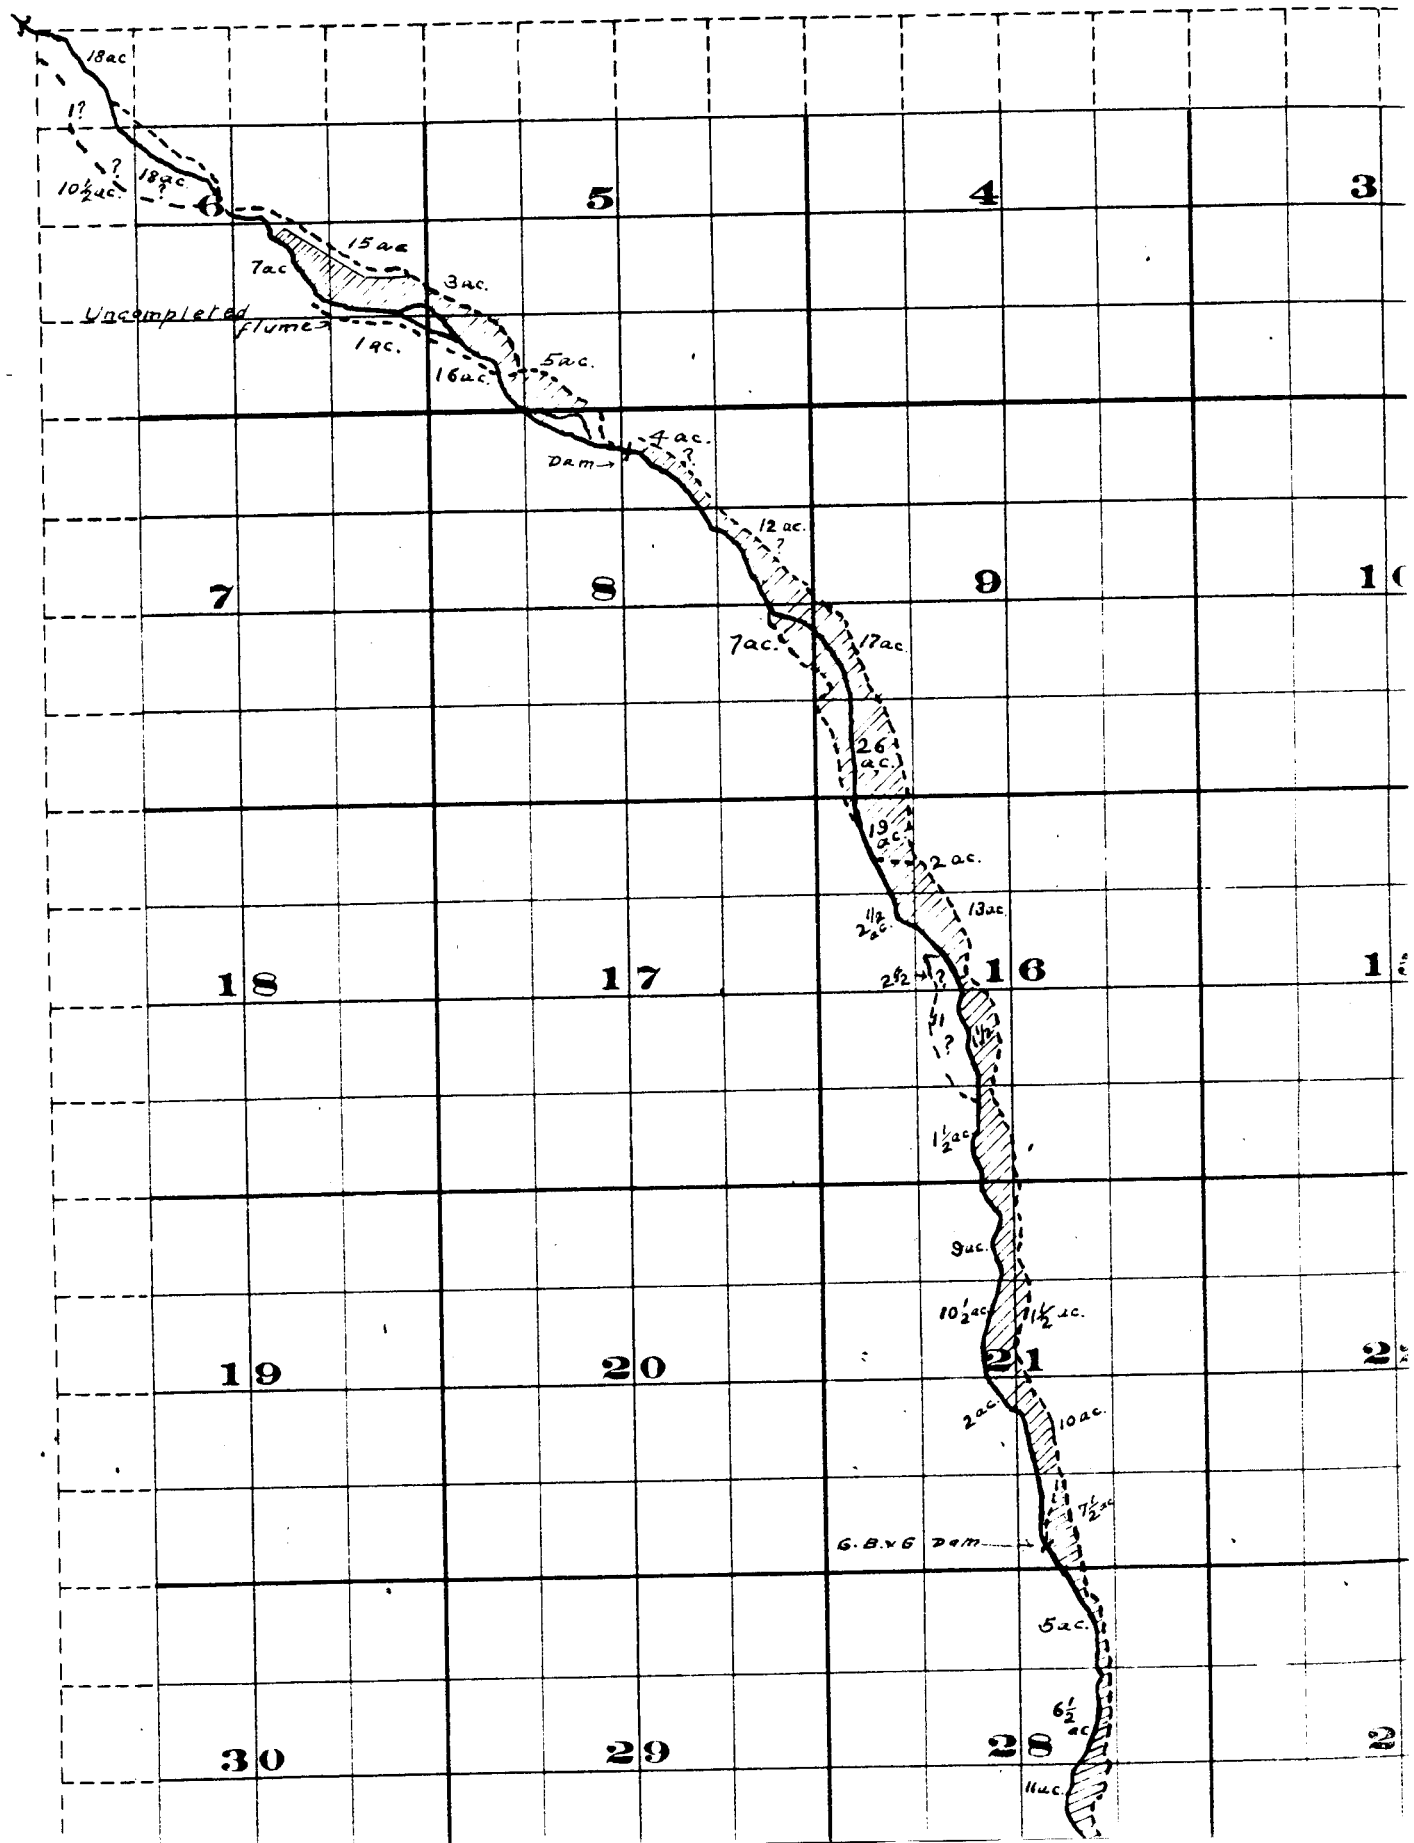

, Range 25 E.W.M. .

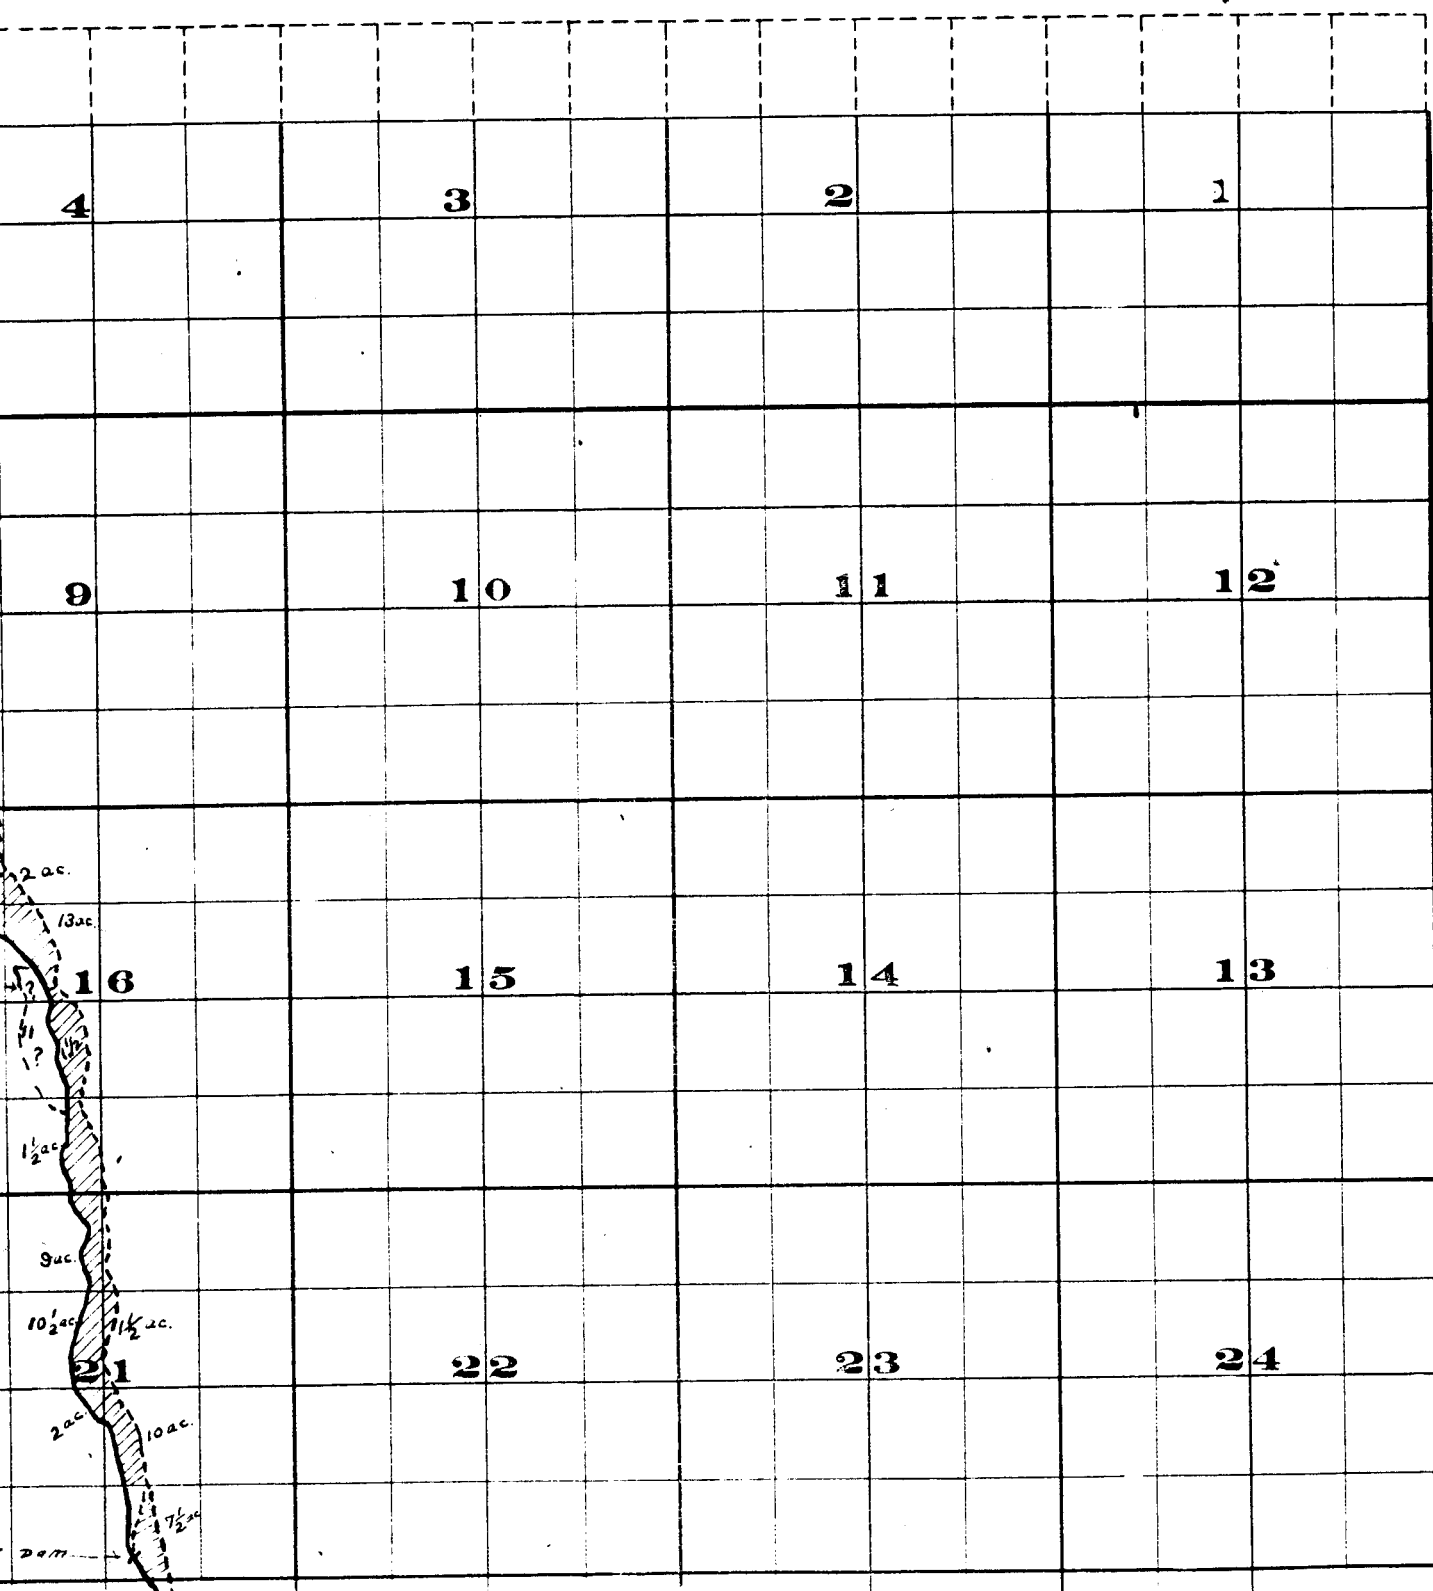

in 40 acre tracts ^{to} the east

15

14

13

22

23

24

27

26

25

34


35

36

FROM OFFICE OF THE STATE ENGINEER, SALEM, OREGON


Willow Creek Adjudication

4 S. 25 E.

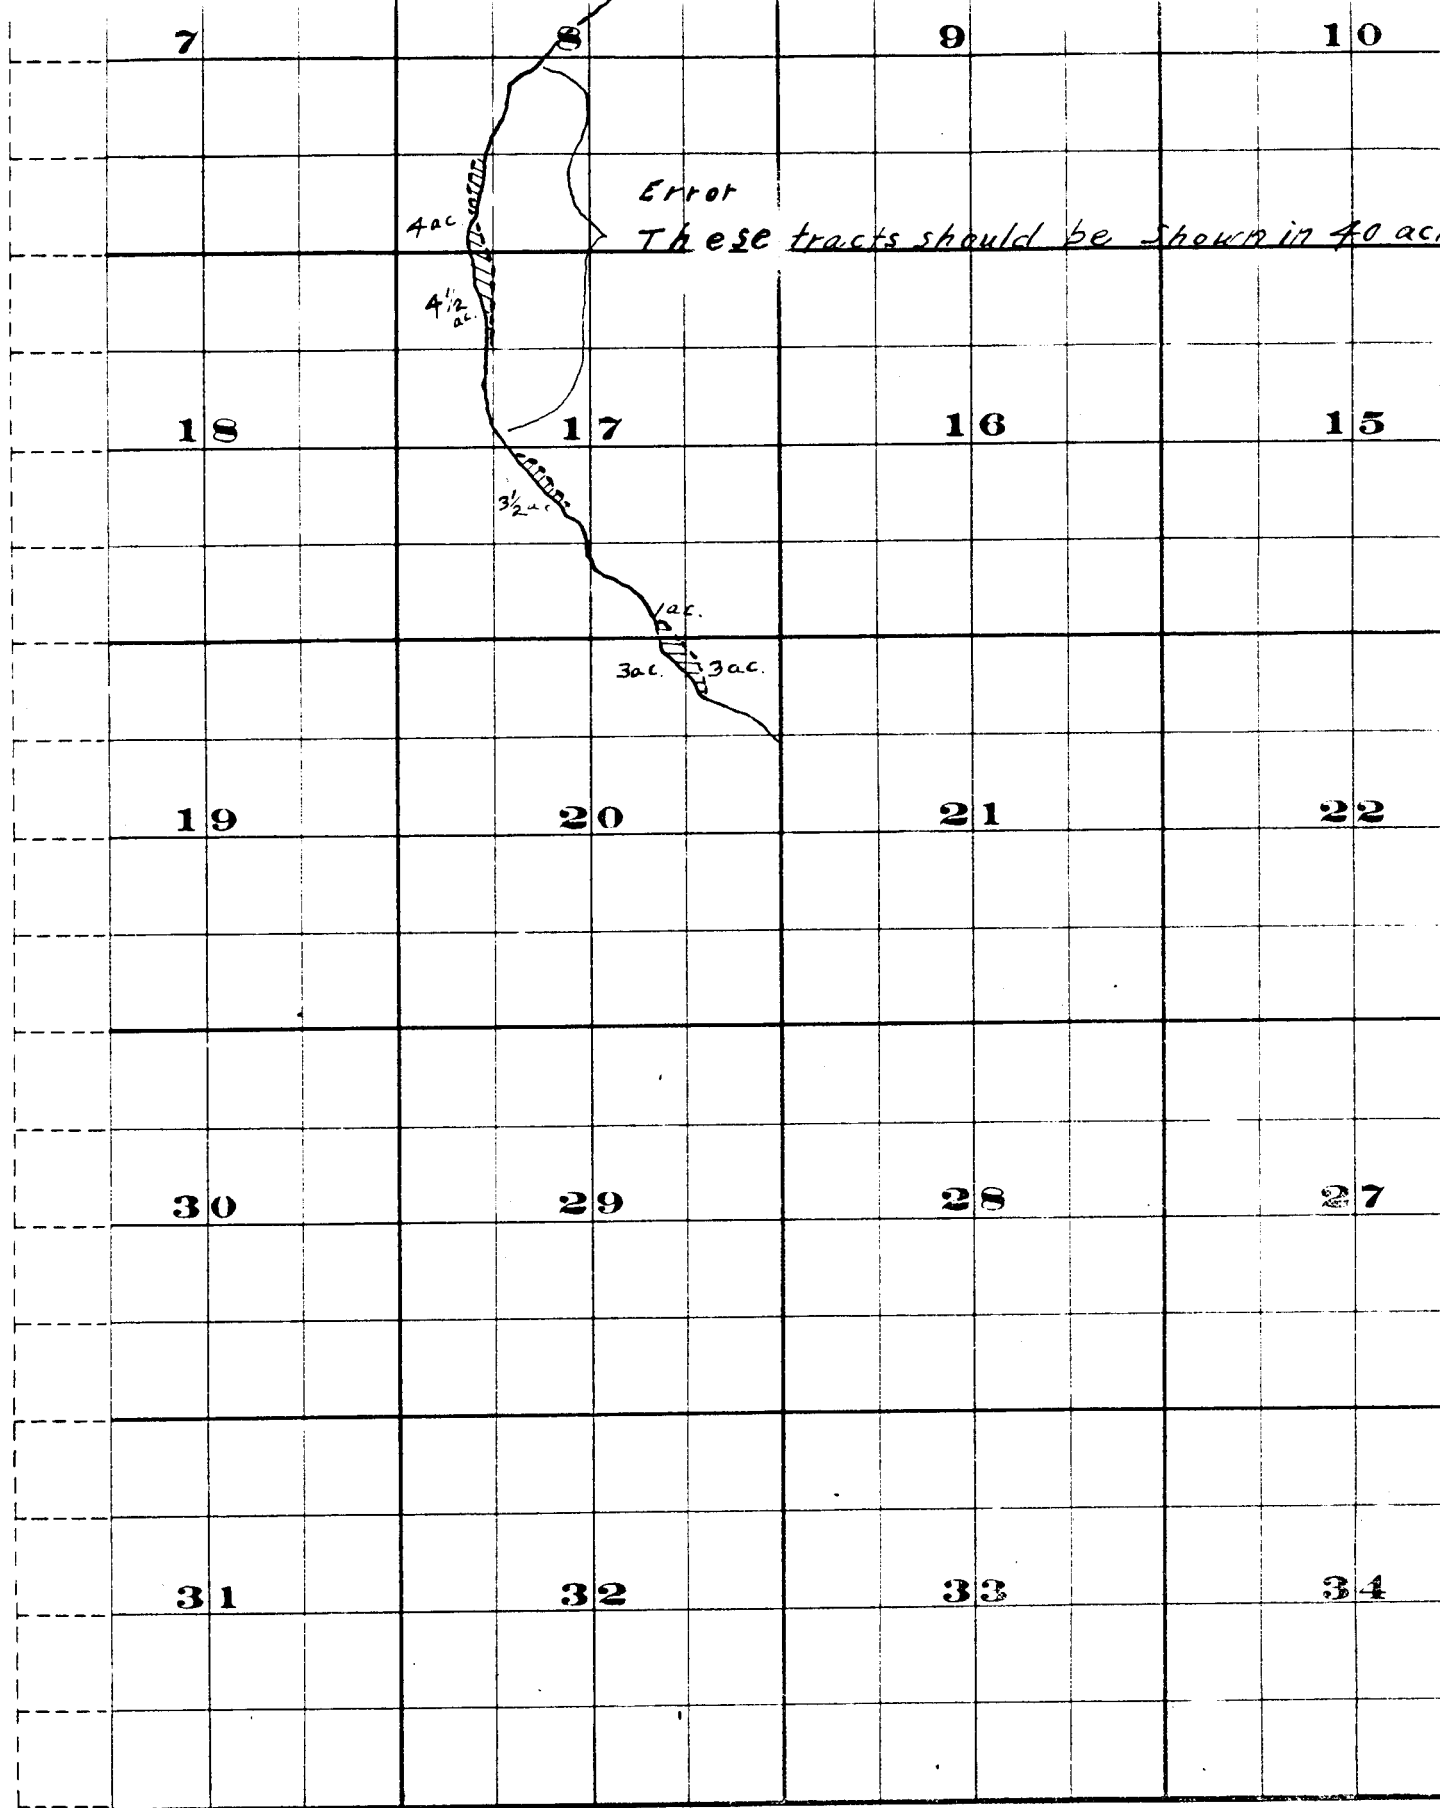

Surveyed by R.D. Cooper - July 1909
 John H. Lewis - State Engineer
 July 14, 1909 - Examined.

Township 4 S.

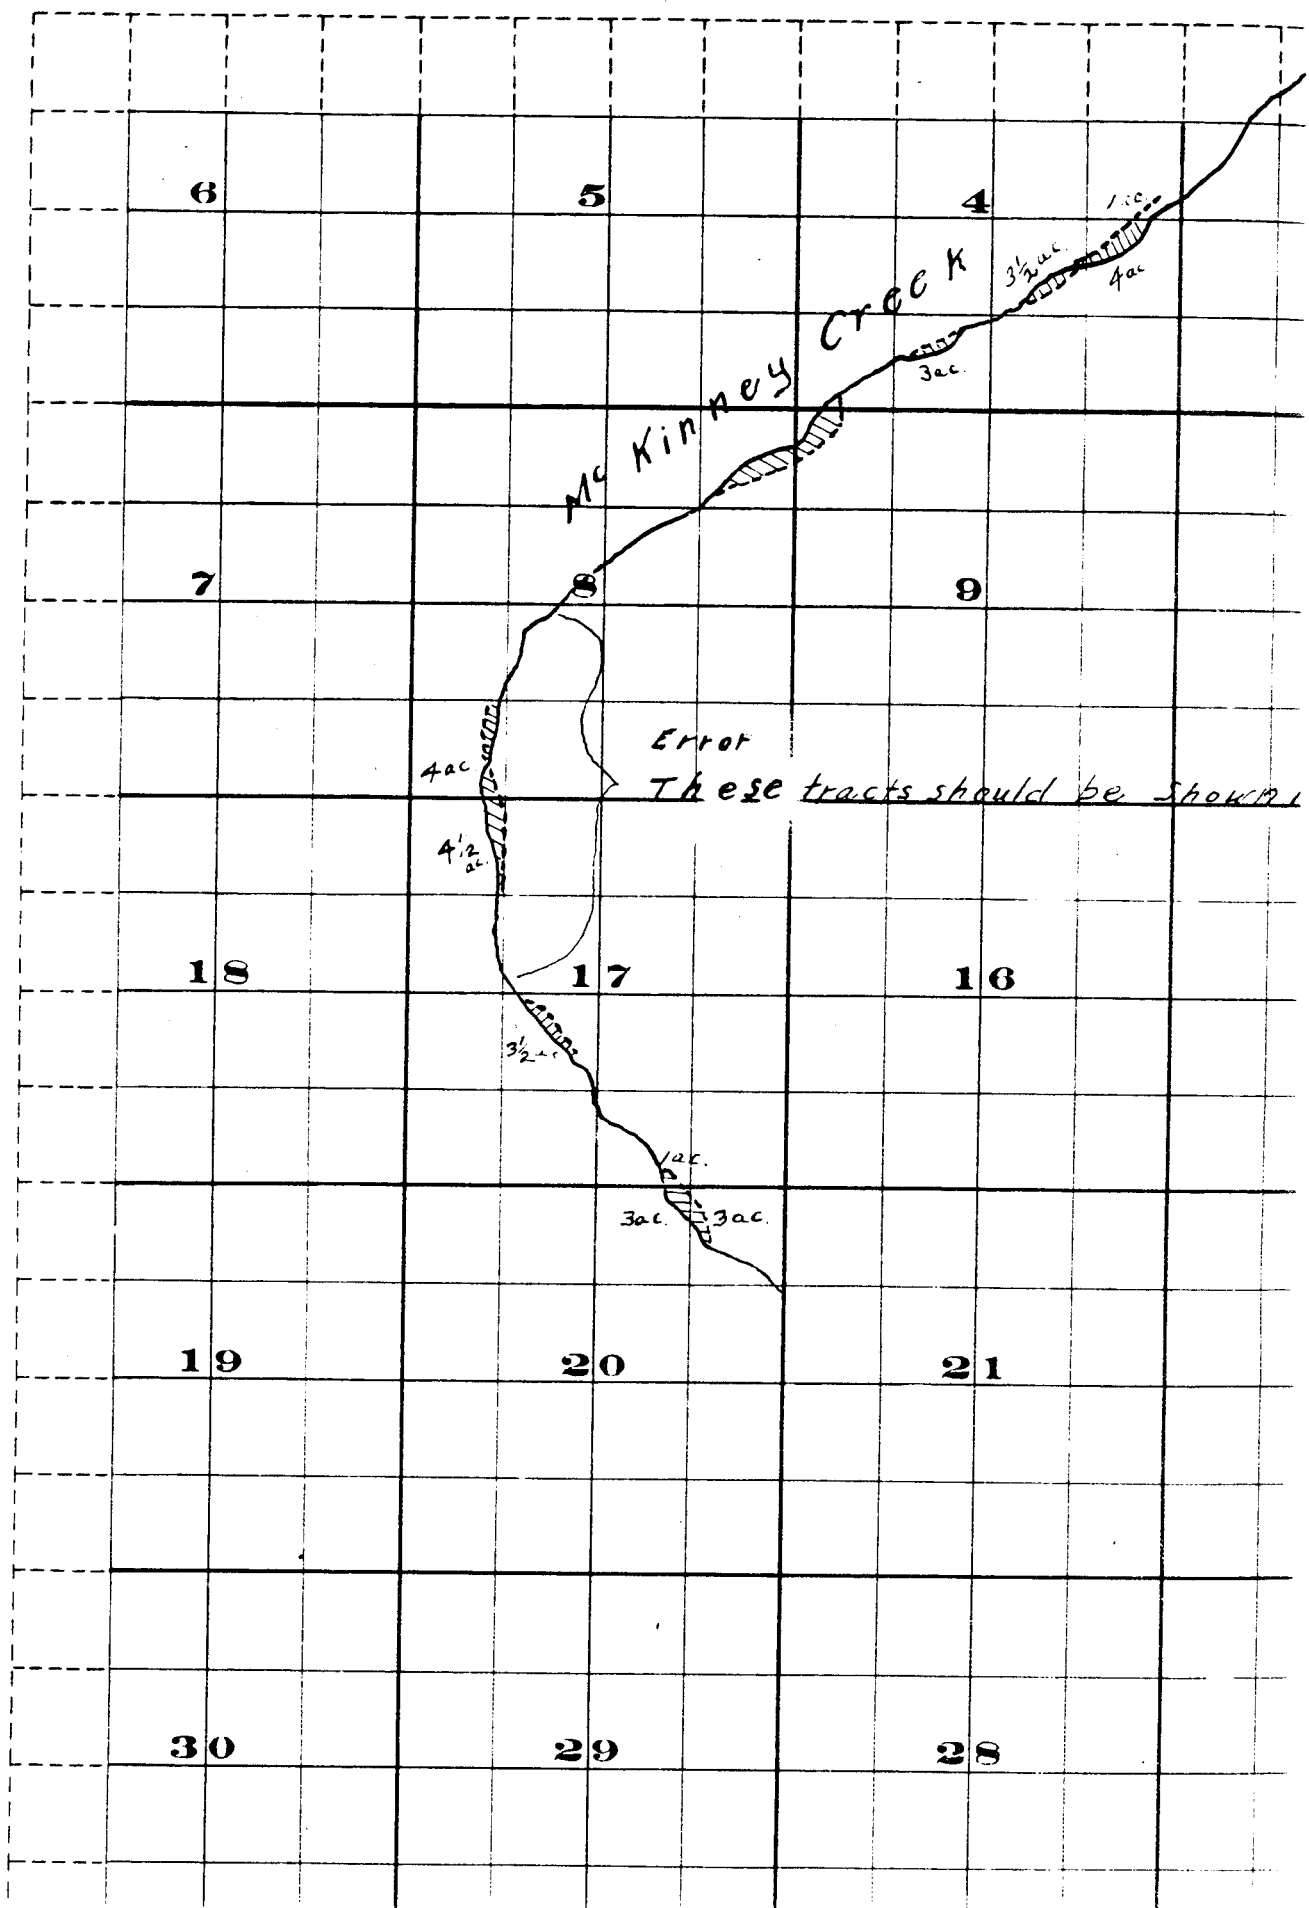

Range 25 E.W.M.

