


T. 7 N. R. 3 W. W. M.

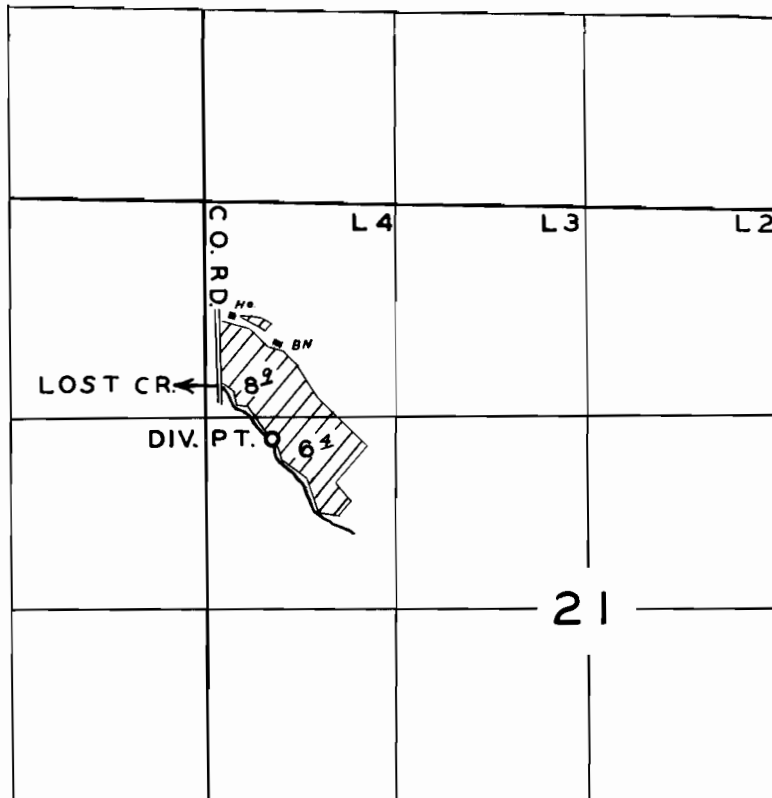

FINAL PROOF SURVEY
UNDER

Application No. 28260... Permit No. 22221.....
IN NAME OF

JOHN P. DILLEY

Surveyed AUG. 27, 1956, by R. H. WHITBY.....