


T. 7 N. R. 2 E. 3 W. W. M.

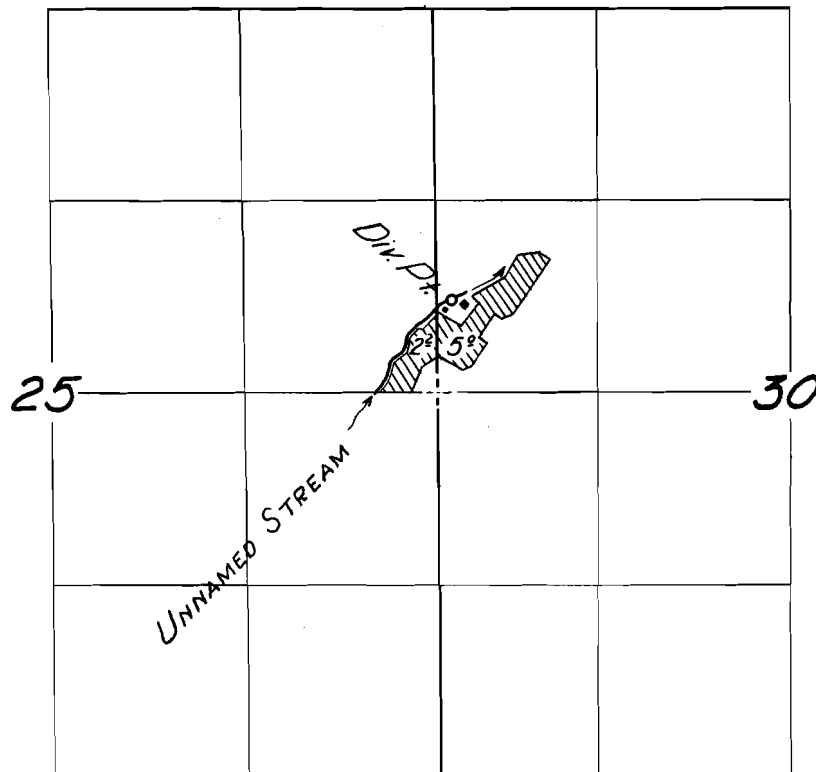

FINAL PROOF SURVEY

UNDER

Application No. 27769 Permit No. 22347

IN NAME OF

G. C. CHRISTLIEB

Surveyed 21 Aug 1956, by R. A. White