


T. 7 S. R. 2 W. W.M.

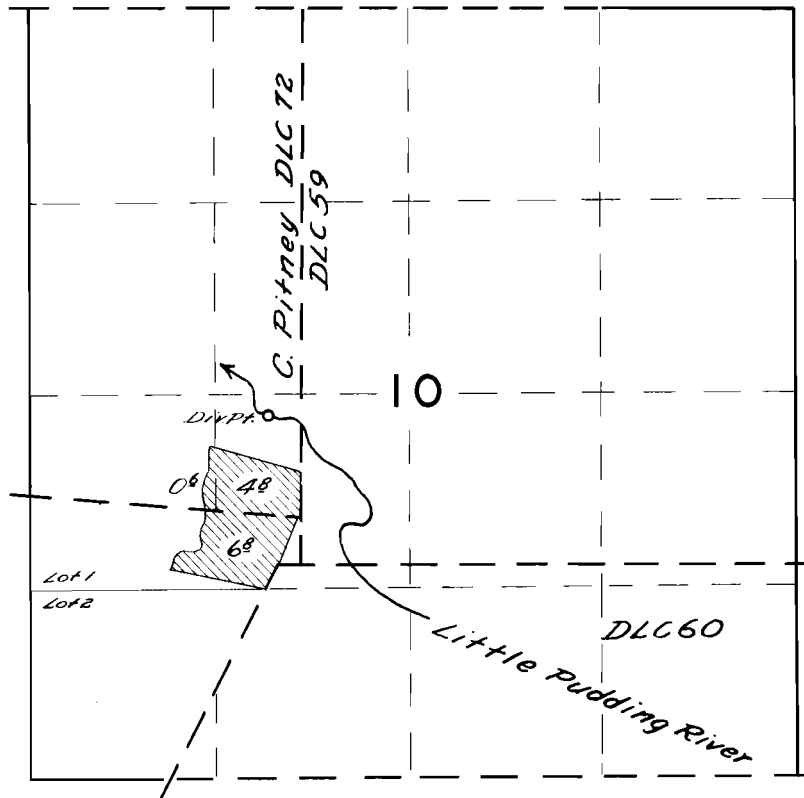

**FINAL PROOF SURVEY**  
UNDER

Application No. 28339 ... Permit No. 28368...  
IN NAME OF

..... *LEONARD PETERSON* .....

Surveyed *May 21 1956*, by *R.H. Whitby*...