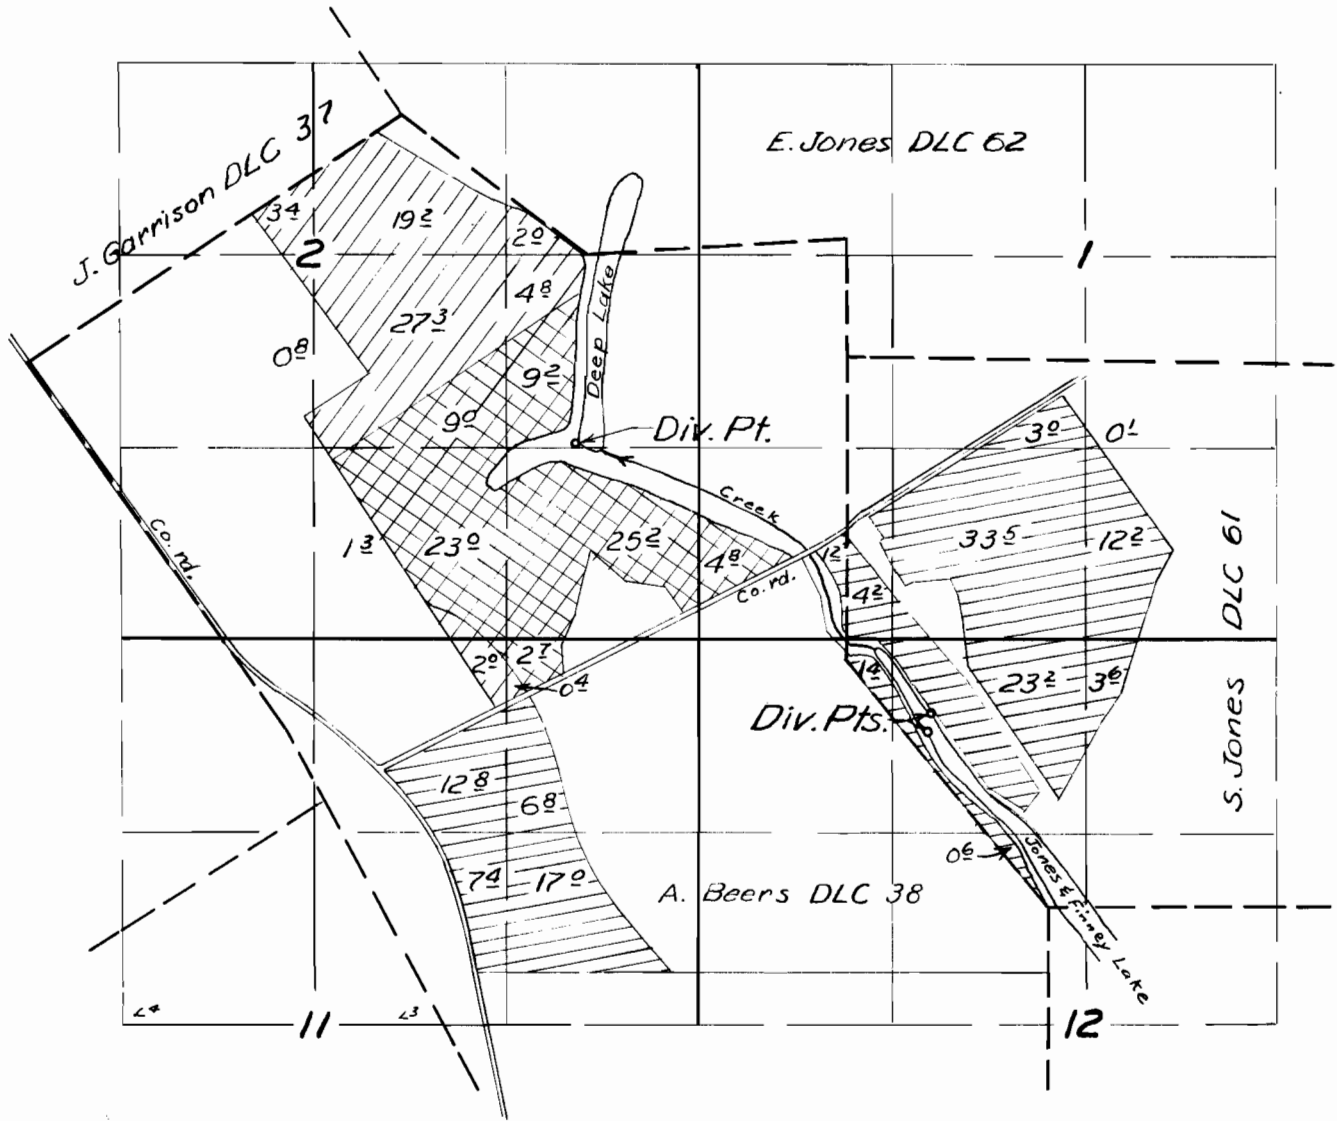


T. 6 S.R.3 W.W. M.


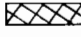



FINAL PROOF SURVEY
UNDER

Application No. 28286 Permit No. 22354.
IN NAME OF

Creighton B. Jones

Surveyed 5 Sept. 1956, by *Tom Bick*

From Deep Lake Prim.  Supp 
From Jones & Finney Lake 

1956 K
DFN-3D-50